


Ellis

KANSAS

SECTION 14 TOWNSHIP 15 RANGE 16 W

WELL NO. #1 Doran

COMPANY W. J. Coppinger

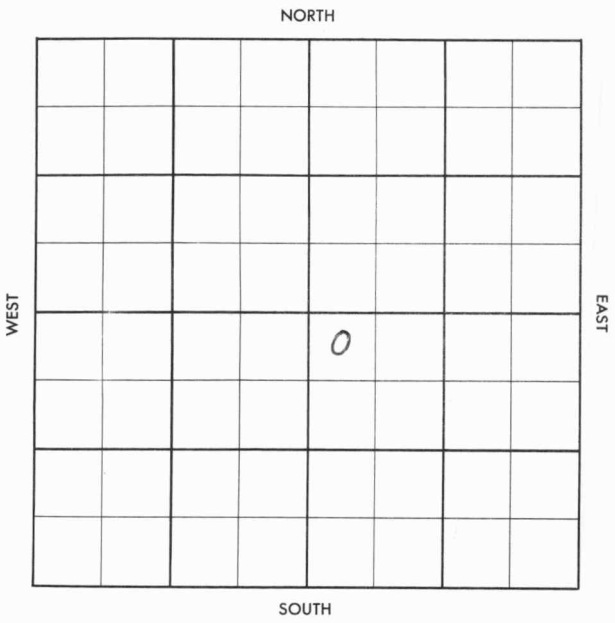

Ellis

KANSAS

SEC. 14	TWP. 15	R. 16W
------------	------------	-----------

WELL NO.

#1 Doran

FARM

COMPANY

W.J. Coppinger

CONTRACTOR

Co. Tools

WILDCAT


_____ Ft. from N. Line

_____ Ft. from S. Line

_____ Ft. from E. Line

_____ Ft. from W. Line

NW NW SE

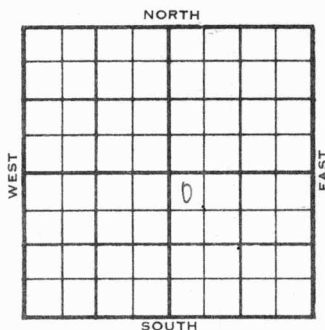

NCRA - Support

	ELEVATION	REPORT
1955	1912'	
12-21	8" @ 240 Drlg. 1895 Anh. 1030'	
1956		
1-5	DST 3482-93 op 1 hr. rec. 15' mud, 760/20" D & A Tp. 2927 H. 3150 Tr. 3170 Dg. 3184 L. 3204 BKC 3429 C. 3454 A. 3482 TD 3518'	

ABANDONED

County **Ellis** Elev. **16W**
 Sec. **14** Twp. **15** Rge. **16W**
 Company **W. J. Coppinger**
 Farm Name **Doran** No. **1**

TOPS	LOG	DATUM	Loc. in Sec.
Anh.			NW NW SE
Tr.			
Dg.			
B.L.			
L.			Geol.
K.C.			Contr.
B.K.C.			Co. tools
Ce.			
C.			Pool
M.			Wildcat
M.			
K.			
Mz.			
Mq.			
V.			
S.			
S.			
A			
R.			
Pf.			
G.			
T.D.			

FIRST REPORT
 DEC 21 '55

Date Comm.

NCRA - support

8" @ 240 drlg. 1895

(Handwritten signature/initials)

County Ellis Elev. 1912
 Sec. 14 Twp. 15 Rge. 16W
 Company W. J. Coppinger
 Farm Name Doran No. 1

TOPS	DEPTH	LOG	DATUM	Loc. in Sec.
Anh.	1030			NW NW SE
Tp.	2927		1015	
H.	3150		1238	
Tr.	3170		1258	
Dg.	3184		1272	
BL.				
L.	3204		1292	Geol.
K.C.				
B.K.C.	3429		1517	Contr.
Ce.				
C.	3454		1542	Co. tools
M.				
M.				Pool
K.				Wildcat
Mz.				
Mq.				
V.				
S.				
S.				
A	3482		1570	ABANDONED
R.				
Pe.				
G.				
T.D.	3518			

Date Comm. JAN 5 1956

8" @ 240 DST 3482-93 open 1 hr.

rec. 15' mud 760/20"

D & A