


Map No. _____ Sec. 24 Twp. 29 R. 5

Well No. 5 Brough Farm
Gardner & Smith Company

NORTH

WEST

EAST

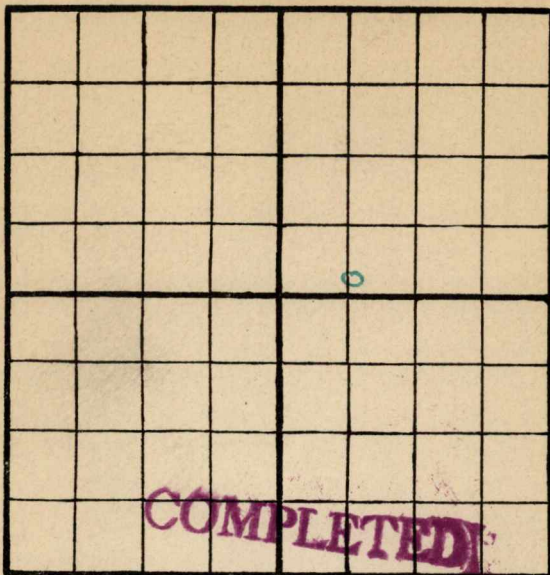

SOUTH

Location _____

Rig Up _____

Drilling Remarks:

Drilling Remarks:

RECORD

PRODUCTION

Cased _____ in. _____ ft.

1st 24 hrs. Nat. _____

Sand _____

1st 24 hrs. after shot _____

Gas _____

Gas _____ cu. ft.

Oil _____

Dry Hole _____

Total Depth _____

Abandoned _____

Map No. K 11 Sec. 24 Twp. 29 R. 5Well No. 5 BushGardner & Smith CompanyGardner & Gardner ContractorAuguste NORTH Ks.

WEST

EAST

SOUTH

FIRST REPORT

Location _____

Rig up ☒

Drilling and Remarks:

FIRST REPORT

RECORD

Cased _____ in., _____ ft.

Sand _____

Gas _____

Oil _____

Total Depth _____

PRODUCTION

1st 24 hrs. Nat. _____

1st 24 hrs. after shot _____


Gas _____ Cu. Ft.

Dry Hole _____

Abandoned _____

Date

6/10 1918 C. Condy Scout

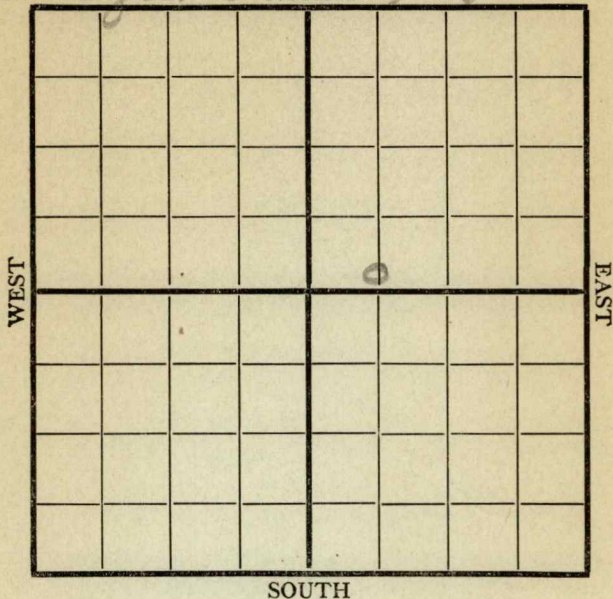Map No. _____ Sec. 24 Twp. 29 R. 5Well No. 5 BushGarden & Smith CompanyDerby & Garden ContractorAugusta NORTH Ks

Location _____

Rig up _____

Drilling and Remarks:

Rigging up**RECORD**

Cased _____ in., _____ ft.

Sand _____

Gas _____

Oil _____

Total Depth _____

PRODUCTION

1st 24 hrs. Nat. _____

1st 24 hrs. after shot _____

Gas _____ Cu. Ft.

Dry Hole _____

Abandoned _____

Date

4/26 1918 J. C. Cawley Scout

Map No. _____ Sec. 24 Twp. 29 R. 5Well No. 5 BushSanderson & Smith Company

Contractor _____

NORTH

WEST

EAST

SOUTH

Location _____

Rig up _____

Drilling and Remarks:

310

RECORD

Cased _____ in., _____ ft.

Sand _____

Gas _____

Oil _____

Total Depth _____

PRODUCTION

1st 24 hrs. Nat. _____

1st 24 hrs. after shot _____

Gas _____ Cu. Ft.

Dry Hole _____

Abandoned _____

Date

7/3 191 J. C. Cady Scout

Map No. _____ Sec. 24 Twp. 29 R. 5Well No. 5 Bush

_____ Company

_____ Contractor

NORTH

WEST

EAST

SOUTH

Location _____

Rig up _____

Drilling and Remarks: _____

RECORD

Cased _____ in., _____ ft.

Sand _____

Gas _____

Oil _____

Total Depth _____

PRODUCTION

1st 24 hrs. Nat. _____

1st 24 hrs. after shot _____

Gas _____ Cu. Ft.

Dry Hole _____

Abandoned _____

Date

7/10

191

Scout

Map No. _____ Sec. 24 Twp. 29 R. 5

Well No. 5 Bush

Garden & Smith Company

Contractor _____

NORTH

WEST

EAST

SOUTH

Location _____

Rig up _____

Drilling and Remarks:

1330

RECORD

Cased _____ in., _____ ft.

Sand _____

Gas _____

Oil _____

Total Depth _____

PRODUCTION

1st 24 hrs. Nat. _____

1st 24 hrs. after shot _____

Gas _____ Cu. Ft.


Dry Hole _____

Abandoned _____

Date

7/17 P. Landry

Map No. _____ Sec. 24 Twp. 29 R. 5
 Well No. 5 Bush
Garden & Smith Company
 Contractor _____

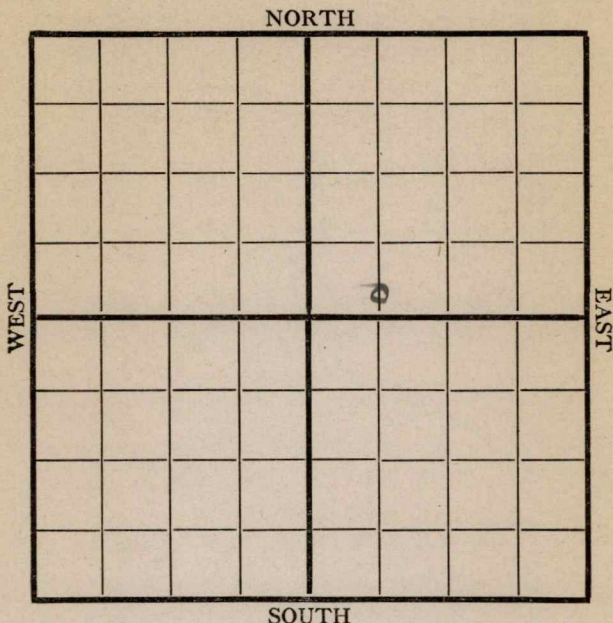

	RECORD
Location _____	Cased _____ in., _____ ft.
Rig up _____	Sand _____
Drilling and Remarks:	Gas _____
	Oil _____
	Total Depth _____
	PRODUCTION
	1st 24 hrs. Nat. _____
	1st 24 hrs. after shot _____
	Gas _____ Cu. Ft.
	Dry Hole _____
	Abandoned _____

Date 7/24 191 S. Condy Scout


Map No. _____ Sec. 24 Twp. 29 R. 5Well No. 5 BushGarben & Quinlan Company

Contractor _____

NORTH

WEST

EAST

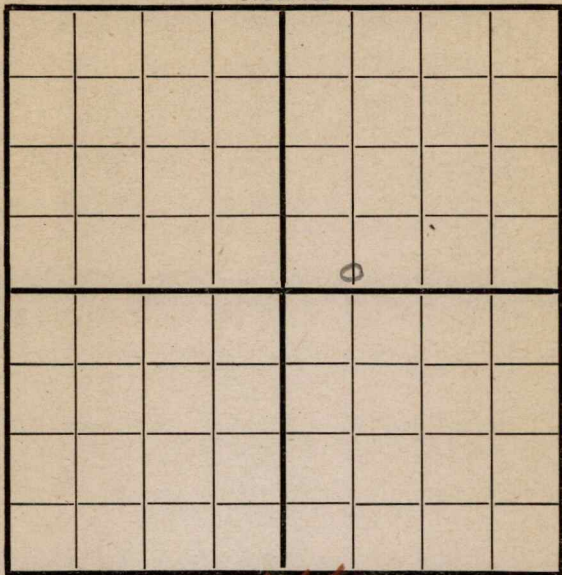

SOUTH

200' S x 660' E

Location _____

Rig up _____

Drilling and Remarks:

RECORD

Cased _____ in., _____ ft.

Sand _____

Gas _____

Oil _____

Total Depth _____

PRODUCTION

1st 24 hrs. Nat. _____

1st 24 hrs. after shot _____

Gas _____ Cu. Ft.

Dry Hole _____

Abandoned _____

Date


7/31 1918 C. Quinlan Scout

Map No. _____ Sec. 24 Twp. 29 R. 5Well No. 5 BushGarden & Smith Company_____
Contractor

NORTH

WEST

EAST

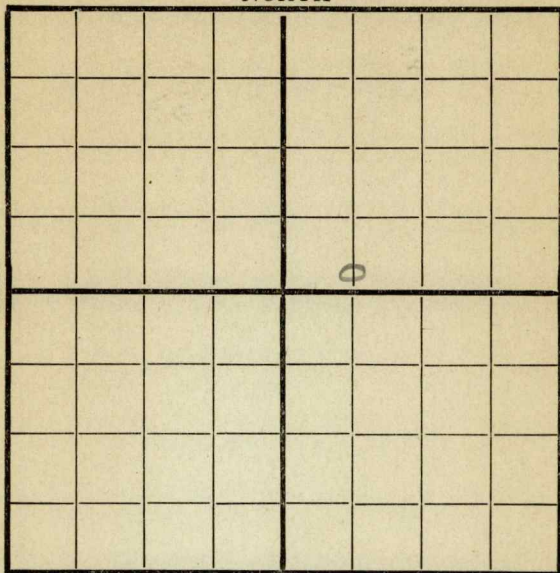

SOUTH

Location 200 A 660 W

Rig up _____

Drilling and Remarks:

2000

RECORD

Cased _____ in., _____ ft.

Sand _____

Gas _____

Oil _____

Total Depth _____

PRODUCTION

1st 24 hrs. Nat. _____

1st 24 hrs. after shot _____

Gas _____ Cu. Ft.

Dry Hole _____

Abandoned _____

Date


8/7

191

8 Condy

Scout

Map No. _____ Sec. 24 Twp. 29 R. 5
 Well No. 5 Bush
Southern & Omaha Company
 Contractor _____

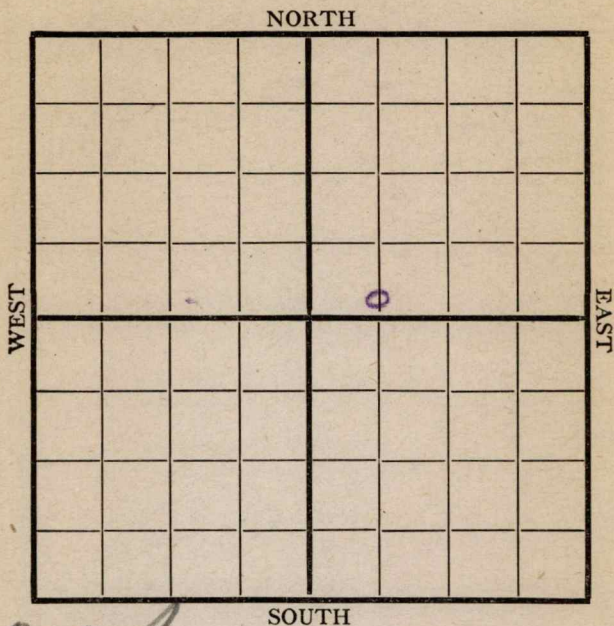

Location 200 L 660 W

Rig up _____

Drilling and Remarks:

MR to
2000

RECORD

Cased _____ in., _____ ft.
 Sand _____
 Gas _____
 Oil _____
 Total Depth _____

PRODUCTION

1st 24 hrs. Nat. _____
 1st 24 hrs. after shot _____
 Gas _____ Cu. Ft.
 Dry Hole _____
 Abandoned _____

Date

8/14 191 S. C. Cuddy Scout


Map No. _____ Sec. 24 Twp. 29 R. 5Well No. 5 BushGarden & Sinter Company

Contractor _____

NORTH

WEST

EAST

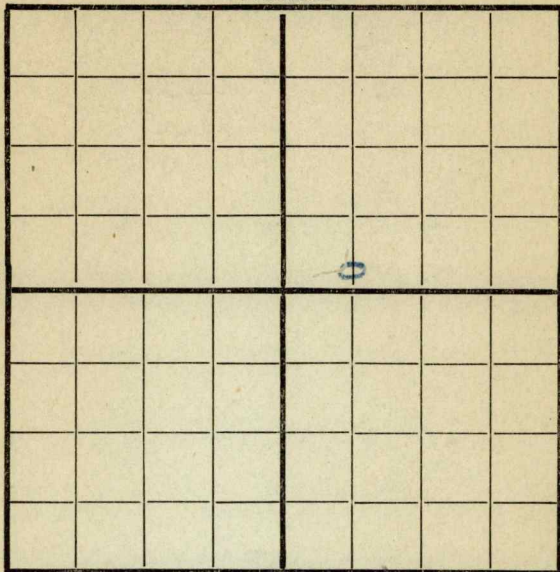

SOUTH

200' S - 600' W

Location _____

Rig up _____

Drilling and Remarks:

No Report
Last depth
2000

RECORD

Cased _____ in., _____ ft.

Sand _____

Gas _____

Oil _____

Total Depth _____

PRODUCTION

1st 24 hrs. Nat. _____

1st 24 hrs. after shot _____

Gas _____ Cu. Ft.

Dry Hole _____

Abandoned _____

Date

8/21 1918 P. Canby Scout


Map No. 1511 Sec. 24 Twp. 29 R. 5Well No. 513
Gardner & Smith Company

Contractor

NORTH

WEST

EAST

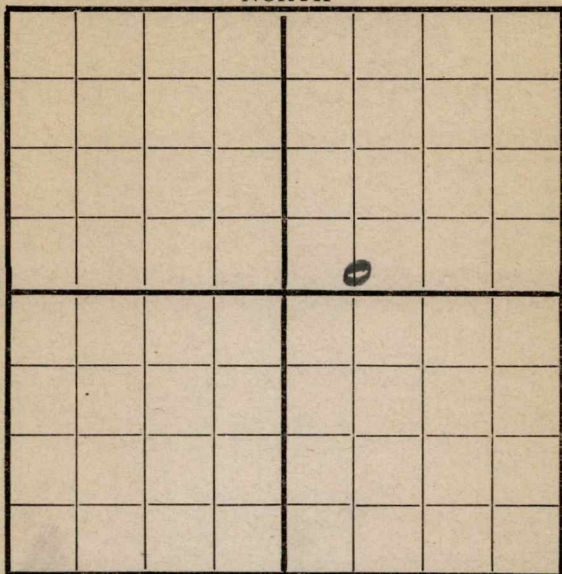

SOUTH

200 S 660 W

Location _____

Rig up _____

Drilling and Remarks:

2200

RECORD

Cased _____ in., _____ ft.

Sand _____

Gas _____

Oil _____

Total Depth _____

PRODUCTION

1st 24 hrs. Nat. _____

1st 24 hrs. after shot _____

Gas _____ Cu. Ft.

Dry Hole _____

Abandoned _____

Date

8/28 191 8 Candy Scout

Map No. 1511 Sec. 24 Twp. 29 R. 5Well No. 5 B...Gardner & Smith Company

Contractor

NORTH

WEST

EAST

SOUTH

Location _____

Rig up _____

Drilling and Remarks:

2400

RECORD

Cased _____ in., _____ ft.

Sand _____

Gas _____

Oil _____

Total Depth _____

PRODUCTION

1st 24 hrs. Nat. _____

1st 24 hrs. after shot _____

Gas _____ Cu. Ft.

Dry Hole _____

Abandoned _____

Date

9/4 191 8 Cardiff Scout


Map No. 111 Sec. 24 Twp. 29 R. 5Well No. 5 BushGordon & Smith Company

Contractor

NORTH

WEST

EAST

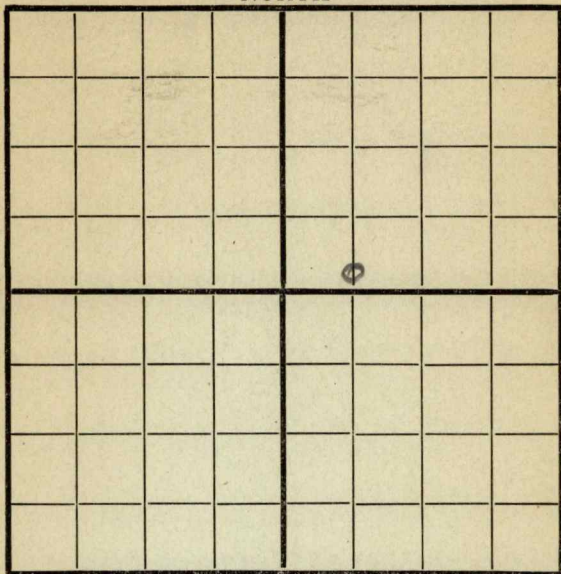

SOUTH

200' S-660' W

Location _____

Rig up _____

Drilling and Remarks:

2530

RECORD

Cased _____ in., _____ ft.

Sand _____

Gas _____

Oil _____

Total Depth _____

PRODUCTION

1st 24 hrs. Nat. _____

1st 24 hrs. after shot _____

Gas _____ Cu. Ft.

Dry Hole _____

Abandoned _____

Date

9/11

191

P. Carey

Scout


Map No. 1511 Sec. 24 Twp. 29 R. 5Well No. 5 BushSanborn & Smith Company

Contractor

NORTH

WEST

EAST

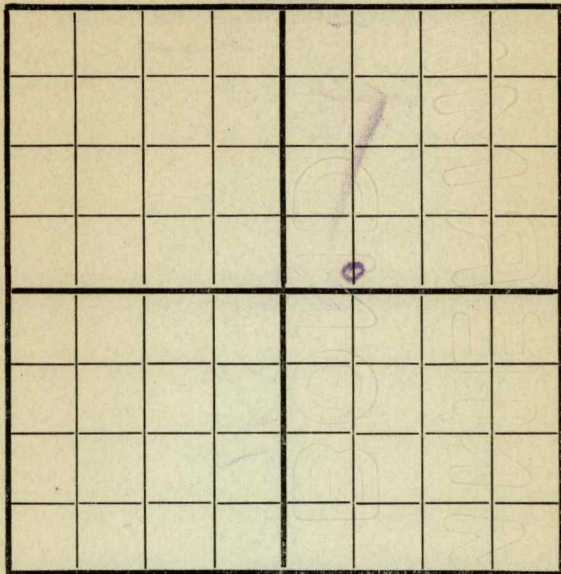

SOUTH

200' A - 660' W

Location _____

Rig up _____

Drilling and Remarks:

Typ sand
2257

RECORD

Cased _____ in., _____ ft.

Sand _____

Gas _____

Oil _____

Total Depth _____

PRODUCTION

1st 24 hrs. Nat. _____

1st 24 hrs. after shot _____

Gas _____ Cu. Ft.

Dry Hole _____

Abandoned _____


Date

9/18 1918 C. C. Conroy

Scout

Map No. K11 Sec. 24 Twp. 29 R. 5Well No. 5 BushGarden & Smith CompanyDerby & Garden ContractorAugusta NORTH 74

WEST

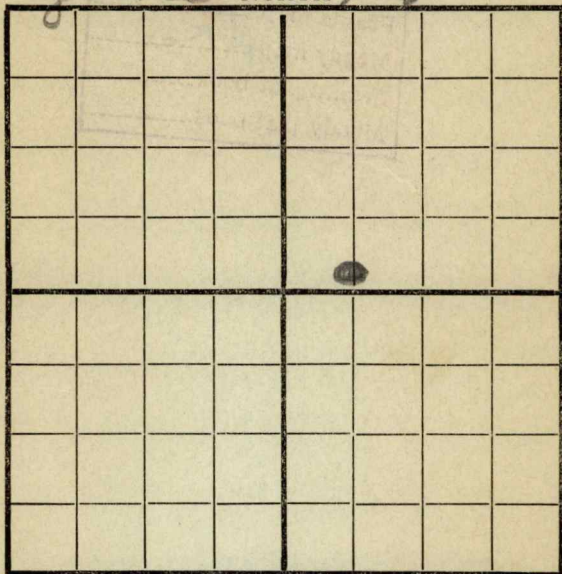

EAST

SOUTH

200 S - 660 W

Location _____

Rig up _____

Drilling and Remarks:

Estimated
9000000
cu ft bar.
100 Bbls oil
natural -

RECORD

Cased _____ in., _____ ft.

Sand 2285 - 2822Gas 2250 - 2260 : 2280 - 2285

Oil _____

Total Depth _____

PRODUCTION

1st 24 hrs. Nat. _____

1st 24 hrs. after shot _____

Gas _____ Cu. Ft.

Dry Hole _____

Abandoned _____

Date

9/25-8 Candy Scout