

KANSAS


FORM 51 5M PETROL

Ellis

Section 35 Township 15 Range 16-W

Well No. #1 Gorham

Company Coralene

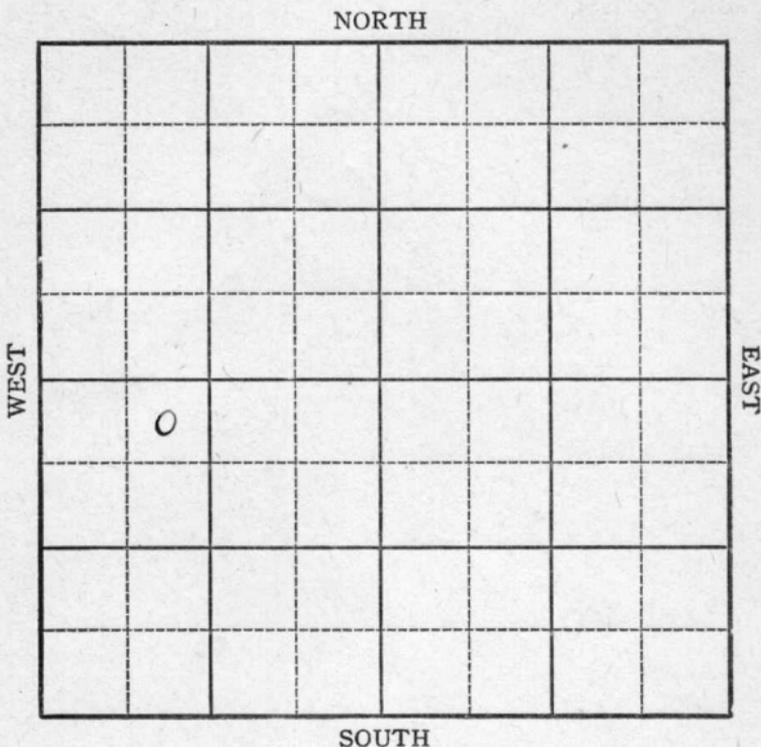


Sec. 35 Twp. 15 R. 16-W

Well No. #1 Gorham Farm

Coralena Company

NORTH

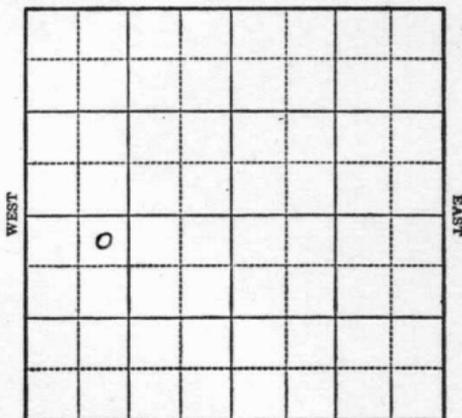

SOUTH

330 Ft. from N. Line

_____ Ft. from S. Line

_____ Ft. from E. Line

990 Ft. from W. Line

Elev. 1863

1943

R E P O R T

9/29 800' Run csg.

10/6 10" @ 785
Anhy 954'
Drlg. 1340'

10/13 Drlg. 2552'

10/20 Topeka 2852
Lans 3150
Drlg. 3150

10/27 7" @ 3278
T.D. 3333-500' oil 1/4 hrs

11/3 1000 acid
Pump 30 oil per hr for 8 hrs.

11/10 Lans 3150
7" @ 3278'
1000 Acid
Pump 1060 Pot.
T.D. 3333'
Gravity 34.8

COMPLETED

KANSAS

Map No. 94 Sec. 35 Twp. 15 R. 16W

Well No. 1 Gorham

Coralena

Company

FIRST REPORT

Contractor

NE NW SW

SECTION PLAT

0			

330 Ft. from N. Line

_____ Ft. from S. Line

_____ Ft. from E. Line

990 Ft. from W. Line

Wildcat

Location _____

Rig up _____

Drilling and Remarks:

800 Run csg.

RECORD

Cased _____ in., _____ ft.

Sand _____

Gas _____

Oil _____

Total Depth _____

PRODUCTION

1st 24 hrs. Nat. _____

1st 24 hrs. after shot _____

Gas _____ Cu. Ft.

Dry Hole _____

Abandoned _____

Date

SEP 29 1943

19

S. J. LEWIS

Scout

Ellis

KANSAS

Map No. 74 Sec. 35 Twp. 15 R. 16W

Well No. 1 Gorham

Coralena

Company

COMPLETED

Contractor

NE NW SW

SECTION PLAT

330 Ft. from N. Line

_____ Ft. from S. Line

_____ Ft. from E. Line

990 Ft. from W. Line

o			

Wildcat

RECORD

Location _____

Cased _____ in., _____ ft.

Rig up _____

Sand _____

Drilling and Remarks:

Gas _____

Oil _____

Total Depth 3333

*Loss 3150
7" @ 3278
10000 acid
Pump 1060 Bx*

PRODUCTION

1st 24 hrs. Nat. _____

1st 24 hrs. after shot _____

Gas _____ Cu. Ft.

Dry Hole _____

Abandoned _____

34 I G

Date

NOV 10 1943 19

S. J. LEWIS

Scout