
FORM 51 25M 3-49 PETROL Russell

KANSAS

Section 23 Township 15 Range 14W

Well No. #8 Ochs

Company Cities Service Oil

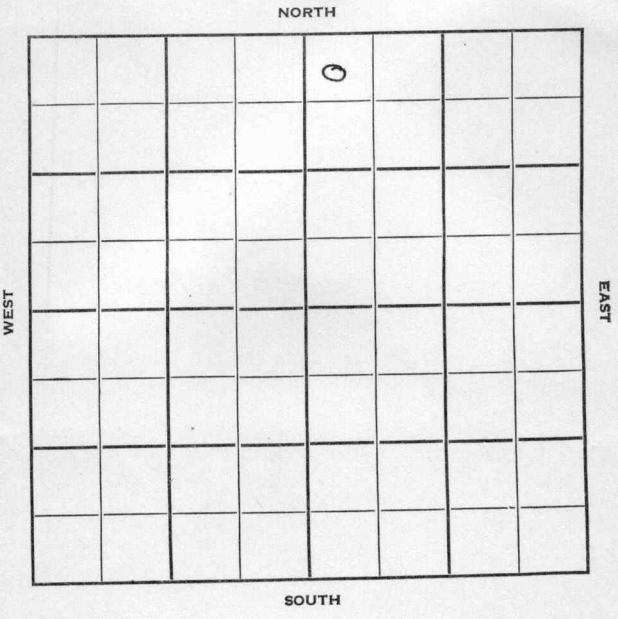

FORM 252-B
10M 8-51 TPCO.

Russell

KANSAS

Sec. 23 Twp. 15 R. 14W

Well No. #8 Ochs Farm

Cities Service Oil Company

Contractor

Trapp Pool


330' Ft. from N. Line

Ft. from S. Line

Ft. from E. Line

330' Ft. from W. Line

NW NW NE

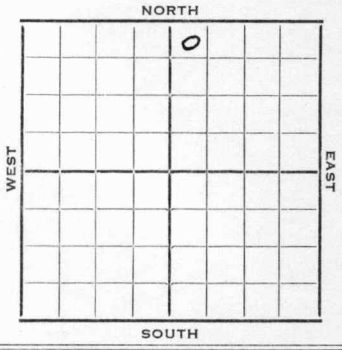

1952	Elev. 1914' REPORT
2/20	Location
3/5	Topeka 2823' Heeb 3061' Dodge 3078' Lans. 3128' Arb. 3364' RTD 3370' 5" @ 3365 WOC
3/11	WOCT
3/19	Spud 2-21-52 Oil Well TD 3370 8" @ 556 Top. 2823 Heeb. 3061 Dodge 3078 Lans. 3128 Arb. 3364 TD 3370 5" @ 3365 CO to 3370 Comp. 73 bopd 18 bw

COMPLETED

FORM 275 FOR SALE BY KANSAS BLUE PRINT CO.

County Russell State Kansas

Sec. 23 (Blk. Twp.) 15 (Sur. Rge.) 14W Map No.

Operator Cities Service Oil

Well No. 8 Farm Ochs

Elev. Location NW NW NE



330 Ft. From N Line NE

330 Ft. From W Line Quarter

1st. Report FEB 20 1952

Completion

Remarks

Spudding Date

Drlg. Data Trapp Pool

Location

J. G. McGEHEE

FORM 275 FOR SALE BY KANSAS BLUE PRINT CO.


County Russell State Kansas

Sec. 23 (Blk. Twp.) 15 (Sur. Rge.) 14W Map No.

Operator Cities Service Oil

Well No. 8 Farm Ochs

Elev. 1914 Location NW NW NE

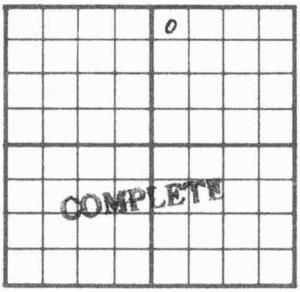

330 Ft. From N Line NE

330 Ft. From W Line Quarter

1st. Report

Completion MAR 1 9 1952

Remarks Trapp Pool

Spudding Date 2-21-52

Drlg. Data Oil well TD 3370

8" @ 556 Top. 2823 Heeb. 3061

Dodge 3078 Lans. 3128 Arb. 3364

TD 3370 5" @ 3365 CO to 3370

Comp. 73 bopd 18 bw

J. G. McGEHEE