

Section 11 Township 34 Range 3 EWell No. # 8 WaltzCompany Gross Drlg.

12

0							

NORTH

SOUTH

WEST

EAST

Cowley **KANSAS**
34 R. 3E

Sec. 11 Twp. 34 R. 3E

Well No. #8 Waltz Farm

Gross Drlg. Company

Gross Drlg. Contractor

Harvey Pool


330 Ft. from N. Line

 Ft. from S. Line

 Ft. from E. Line

330 Ft. from W. Line

NW NW SW

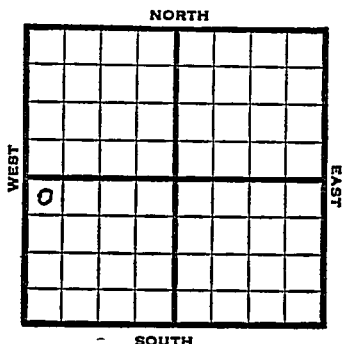

1953 Elev. 1149' REPORT

4/29 Cellar & Pits
7/29 Spud 6-10-53
Oil Well
TD 3335
8" @ 60
KC 2830, Bart 3304
TD 3328
5" @ 3326
DD 3335, Hydro
Comp. 117 bopd

COMPLETED

County **Cowley** State **Kansas**

Sec. **11** (Blk. **34** (Sur. **3E** Map No.

Operator **Gross Drig.**

Well No. 8 Farm Waltz

Elev.	Location	NW NW SW
-------	----------	----------

2

FIRST REPORT

330 Ft. From N Line SE

330 Ft. From W Line Quarter

1st. Report APR 29 1953

Completion

Remarks

Gross Drlg. - Contr.

Spudding Date _____

Drig. Data Harvey Pool

Cellar & pits

J. G. McGEHEE

County Cowley State Kansas

Sec. 11 (Blk. Twp.) 34 (Sur. Rge.) 3E Map No.

Operator Gross Drlg.

Well No. 8 Farm Waltz

Elev.	1149	Location	NW NW SW
-------	------	----------	----------

0

COMPLETE

330 Ft. From N Line SW

330 Ft. From W Line Quarter

1st. Report

Completion JUL 29 1953

Remarks Harvey Pool

Gross Drlg. - Contr.

Spudding Date 6-10-53

Drig. Data Oil well TD 3335

8" @ 60 KC 2830 Bart. 3304 TD 3328

5" @ 3 326 DD 3335 Hydro.

Comp. 117 bopd

J. G. McGEHEE