

KANSAS


Ellis

FORM 51 5M BRIX

Section 34 Township 15 Range 16W

Well No. #1 Bacon
#3, Boeching

Company Coralena

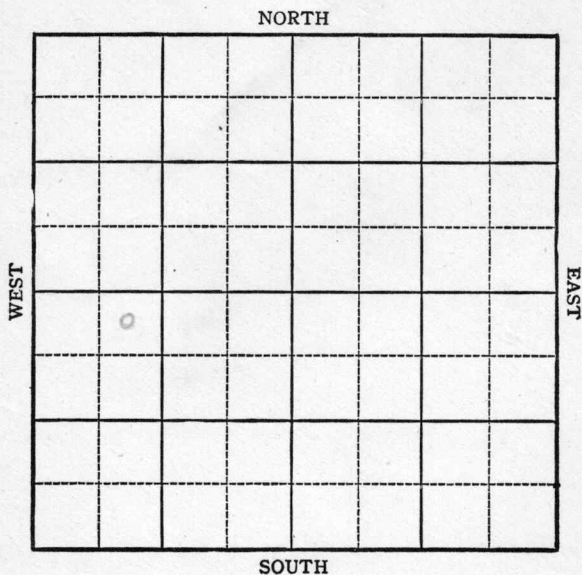

KANSAS

Ellis

Sec. 34 Twp. 15 R. 16W

Well No. #3, Beeching #1 Bacon Farm
Coralena Company


Beeching

330 Ft. from N. Line

 Ft. from S. Line

 Ft. from E. Line

990 Ft. from W. Line

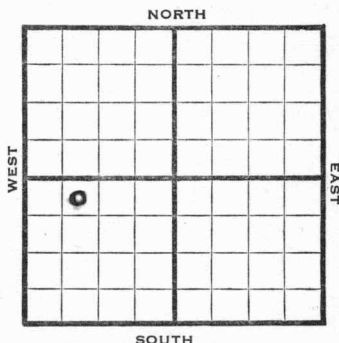

1944

R E P O R T

5/31 Drlg. 675'

6/7 10" @ 931

Drlg. 2310'

6/15 Drlg 3229

6/21 Lans 3126

SO 3141-48, 3158-61 3278-83

TD 3310

7" @ 3276 RUST

6/28 6000 acid SS0

7/12 " " "

7/19 " " "

7/26 " " "

8/2 " " "

8/9 " " "

8/16 " " "

8/23 " " "

8/30 " " "

9/8 " " "

9/13 " " "

9/21 3000 gacid

9/28 " "

10/4 " "

10/11 " "

10/18 TD 3301 PB 800 acid

10/25 Lans 3126

7" @ 3276 10000 acid

TD 3310 Water

ABANDONED

Pool Name BeechingMap No. 34 Sec. 15 Twp. 16 WWell No. 3 BeechingCoralena Company

FIRST REPORT

Contractor

NE NW SW

SECTION PLAT

330 Ft. from N. Line

Ft. from S. Line

Ft. from E. Line

990 Ft. from W. LineEllis County

Location

Rig up

Drilling and Remarks:

675'

RECORD

Cased in. ft.

Sand

Gas

Oil

Total Depth

PRODUCTION

1st 24 hrs. Nat.

1st 24 hrs. after shot

Gas Cu. Ft.

Dry Hole

Abandoned

Date

MAY 31 1944

19

S. J. LEWIS

Scout

KANSAS

Pool Name BeechingMap No. 74 Sec. 34 Twp. 15 R. 16WWell No. 1 BaconCoralena

Company

CORRECTION

Contractor

NE NW SW

SECTION PLAT

330


Ft. from N. Line

Ft. from S. Line

Ft. from E. Line

990

Ft. from W. Line

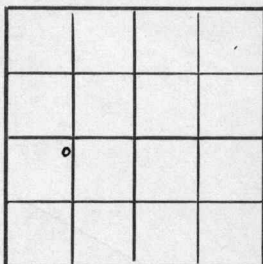Ellis County

Location

Rig up

Drilling and Remarks:

Reported**#3 Beeching**

RECORD

Cased _____ in., _____ ft.

Sand _____

Gas _____

Oil _____

Total Depth _____

PRODUCTION

1st 24 hrs. Nat. _____

1st 24 hrs. after shot _____

Gas _____ Cu. Ft.

Dry Hole _____

Abandoned _____

Date

JUN 7 1944

19

S. J. LEWIS


Scout

KANSAS

Pool Name Beeching PoolMap No. 24 Sec. 34 Twp. 15 R. 16WWell No. 1 BaconCoralena CompanyABANDONED Contractor

NE NW SW

SECTION PLAT

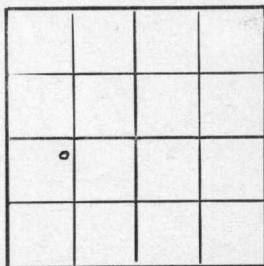330 Ft. from N. Line Ft. from S. Line Ft. from E. Line990 Ft. from W. LineEllis County

RECORD

Location Rig up

Drilling and Remarks:

Lease 8126
7 "C 8276
10000 acid
Water

Cased in, ft.Sand Gas Oil Total Depth 3310

PRODUCTION

1st 24 hrs. Nat. 1st 24 hrs. after shot Gas Cu. Ft.Dry Hole Abandoned

Date

OCT 25 1944

19

S. J. LEWIS Scout