


Map No. _____ Sec. 24 Twp. 29 R. 5
Well No. 6 Bush Farm
Wizzard Oil Company
NORTH

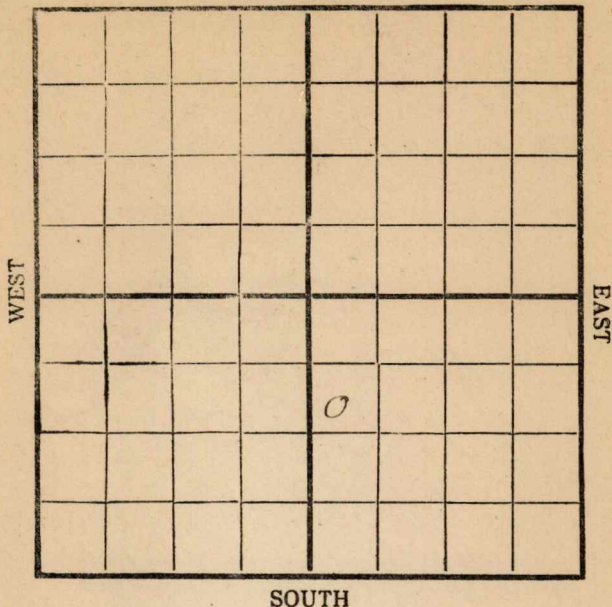

Location _____

Drilling Remarks:

Rig Up -----

Drilling Remarks:

RECORD

Cased-----in. -----ft.

Sand -----

Gas -----

Oil_____

Total Depth -----

PRODUCTION

1st 24 hrs. Nat.-----

1st 24 hrs. after shot-----

Gas_____cu. ft

Dry Hole -----


Abandoned -----

Map No. K 11 Sec. 24 Twp. 29 R. 5Well No. 6 Bush
Hizzard Oil Company
Contractor

NORTH

WEST

EAST

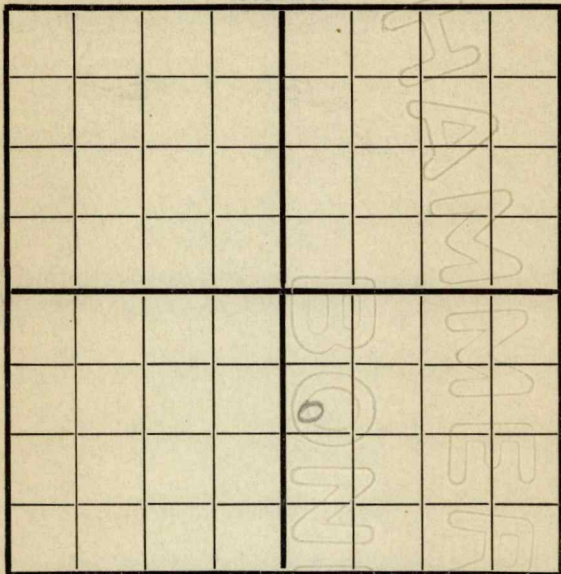

SOUTH

250 W1070 N

Location _____

Rig up _____

Drilling and Remarks:

Top 02752
Hole full oil
15 1/2 feet

RECORD

Cased _____ in., _____ ft.

Sand _____

Gas _____

Oil _____

Total Depth _____

PRODUCTION

1st 24 hrs. Nat. _____

1st 24 hrs. after shot _____

Gas _____ Cu. Ft.

Dry Hole _____

Abandoned _____

Date

7/21 1919 Cycle Scout