
KANSAS Russell

FORM 51 5M 4-41 PETROL

Section 23 Township 15 Range 14-W

Well No. #4 Ochs

Company Cities Service Oil

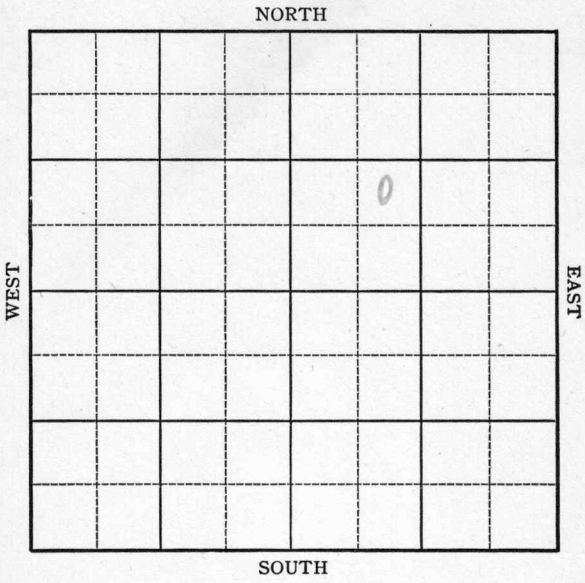

FORM 252-A
5M 10-41 PETROL


KANSAS Russell

Sec. 23 Twp. 15 R. 14-W

Well No. #4 Ochs Farm

Cities Service Oil Company

(Trapp)

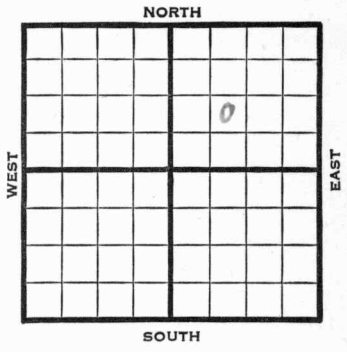

_____ Ft. from N. Line

990 Ft. from S. Line

_____ Ft. from E. Line

990 Ft. from W. Line

Elev. 1914

1941	REPORT
10/29	Rotary.
11/6	8" - 337' Drlg. 1150'
11/13	Drlg. 2703'
11/20	Arb. 3371' T.D. 3373'
	5" - 3371' RUST.
11/25	Arb. 3366'
	5" - 3366'
	T.D. 3373'
	1500 acid.
	Potential 69 bbls., pump.
	39. Gravity
	COMPLETED

Form 26 200 Bks. 5-41 McW. Russell KANSAS

Map No. K-23 Sec. 23 Twp. 15 R. 14W

Well No. 4 Ochs

Cities Service Oil Company

FIRST REPORT Contractor

NE SW NE

Ft. from N. Line


990 Ft. from S. Line

Ft. from E. Line

990 Ft. from W. Line

TRAPP POOL

SECTION PLAT

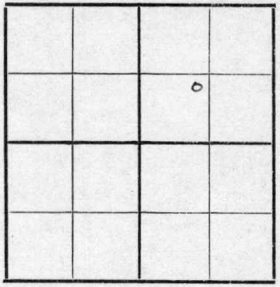

Location

Rig up

Drilling and Remarks:
Rotary

RECORD

Cased in., ft.

Sand

Gas

Oil

Total Depth

PRODUCTION

1st 24 hrs. Nat.

1st 24 hrs. after shot

Gas Cu. Ft.

Dry Hole

Abandoned

Date

OCT 29 1941 19

S. J. LEWIS Scout

Form 26 200 Bks. 5-41 McW. Russell KANSAS

Map No. K-23 Sec. 23 Twp. 15 R. 14W

Well No. 4 Ochs

Cities Service Oil Company

COMPLETED Contractor

NE SW NE

Ft. from N. Line


990 Ft. from S. Line

Ft. from E. Line

990 Ft. from W. Line

TRAPP POOL

SECTION PLAT

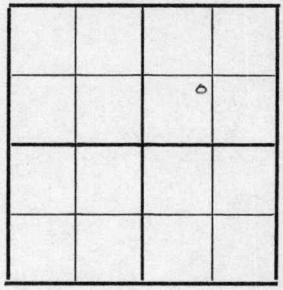

Location

Rig up

Drilling and Remarks:

Cir & 3366
5 "@3366
1500 Gals "C
Pump 69 B/D.

39° Gr

RECORD

Cased in., ft.

Sand

Gas

Oil

Total Depth 3373

PRODUCTION

1st 24 hrs. Nat.

1st 24 hrs. after shot

Gas Cu. Ft.

Dry Hole

Abandoned

Date

NOV 25 1941 19

S. J. LEWIS Scout