KANSAS

FORM 51 5M 10-41 PETROL


Russell

Section 23 Township 15 Range 14-W

Well No. #5 Ochs

Company Cities Service Oil

Trapp Pool

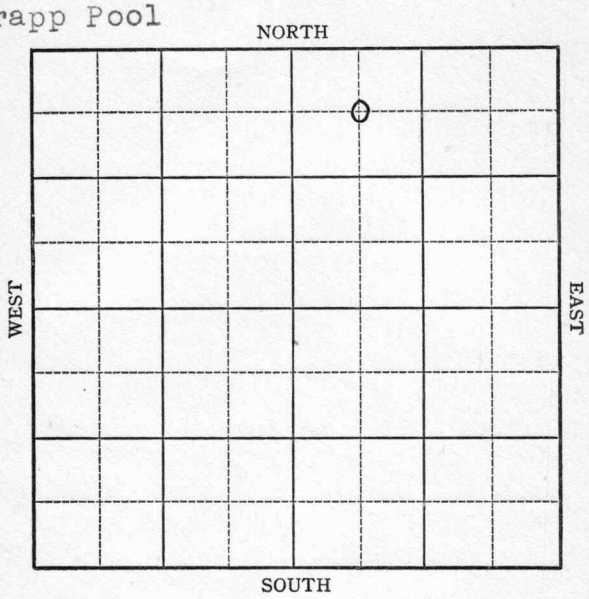

Form 252-A
5M 5-42 Petrol

KANSAS

Russell

Sec. 23 Twp. 15 R. 14-W

Well No. #5 Ochs Farm

Cities Service Oil Company


Trapp Pool

660 Ft. from N. Line

Ft. from S. Line

Ft. from E. Line

660 Ft. from W. Line

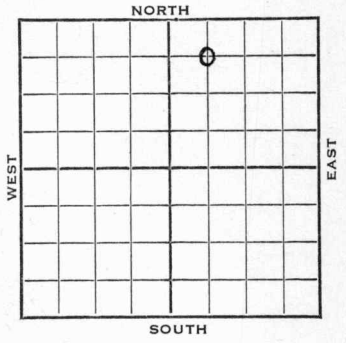

C NW NE Elev. 1915 DF 1912 Gr.

1942	REPORT
12/9	Loc.
12/16	S H 135'
12/22	8" @ 349' Drlg. 400'
12/29	SD 400
1943 1/6	Drlg. 2340'
1/13	Arb. 3371 T.D. 3374' Run 4"
1/20	4" Casing set 3372' RUST
1/27	" " " "
2/3	" " " "
2/10	" " " "
2/17	Arb 3368 Corrected 4" Casing set 3369 TD 3379-1500# oil 12 hrs.
2/24	Arb. 3368 4" @ 3369' Pump 120 Pot. Gravity 39 T.D. 3379'

COMPLETED

Form 26 200 Bks 5-42 Petrol

Russell

KANSAS

Map No. 73 Sec. 23 Twp. 15 R. 14W

Well No. 5 Ochs

Cities Service Oil Company

FIRST REPORT Contractor

C NW NE


660 Ft. from N. Line

Ft. from S. Line

Ft. from E. Line

660 Ft. from W. Line

SECTION PLAT

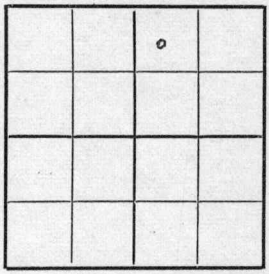

TRAPP POOL

Location XXX

Rig up

Drilling and Remarks:

RECORD

Cased in., ft.

Sand

Gas

Oil

Total Depth

PRODUCTION

1st 24 hrs. Nat.

1st 24 hrs. after shot

Gas Cu. Ft.

Dry Hole

Abandoned

Date

DEC 9 1942 19

S. J. LEWIS Scout

Form 26 200 Bks 5-42 Petrol

Russell

KANSAS

Map No. 73 Sec. 23 Twp. 15 R. 14W

Well No. 5 Ochs

Cities Service Oil Company

COMPLETED Contractor

C NW NE


660 Ft. from N. Line

____ Ft. from S. Line

____ Ft. from E. Line

660 Ft. from W. Line

SECTION PLAT

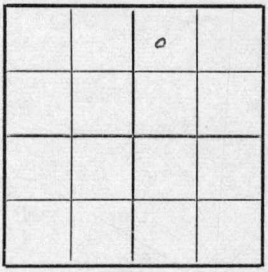

TRAPP POOL

Location

Rig up

Drilling and Remarks:

Cir & 3368
4"@3369
Pump 120 BF
39° Gr

RECORD

Cased ____ in., ____ ft.

Sand

Gas

Oil

Total Depth 3379

PRODUCTION

1st 24 hrs. Nat.

1st 24 hrs. after shot

Gas ____ Cu. Ft.

Dry Hole

Abandoned

Date

FEB 24 1943 19

S. J. LEWIS Scout