

Cowley

KANSAS



Sec. 11 Twp. 34 R. 3E

Well No. #3
~~#1~~ Waltz Farm

Gross Drlg. Company Company

Gross Drlg. - Contr. Contractor


 Ft. from N. Line

990 Ft. from S. Line

 Ft. from E. Line

990 Ft. from W. Line

NE SW SW

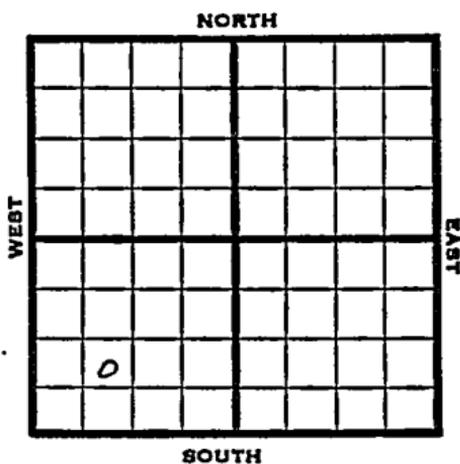

1953

Elev. 1153'

REPORT

3/11

R U R

4/8

Spud 3-10-53

Oil Well

TD 3337

8" @ 68

Layton 2635, KC 2823,

DST 2822-32, opn 1/2 hrs., rec. 5' socm

52#

Bart 3305

TD 3337

5" @ 3323,

CO to 3337, 60 bopd, hydro

Comp. 518 bopd

COMPLETED

Map No. _____ Sec. 11 Twp. 34 R. 3EWell No. 3 Waltz

Gross Drlg. _____ Company _____

CORRECTION Contractor _____

NE SW SW

SECTION PLAT

_____ Ft. from N. Line

990 Ft. from S. Line

_____ Ft. from E. Line

990 Ft. from W. Line

o			

Cowley County

Location _____

Rig up _____

Drilling and Remarks:

Reported
#4 Waltz

RECORD

Cased _____ in., _____ ft.

Sand _____

Gas _____

Oil _____

Total Depth _____

PRODUCTION

1st 24 hrs. Nat. _____

1st 24 hrs. after shot _____

Gas _____ Cu. Ft.

Dry Hole _____

Abandoned _____

Date

MAR 11 1953 19

J. G. McGEHEE Scout

