


Section 23 Township 15 Range 14-W

Well No. 2 Resner

Company Republic Natural Gas

NORTH

Trapp Pool

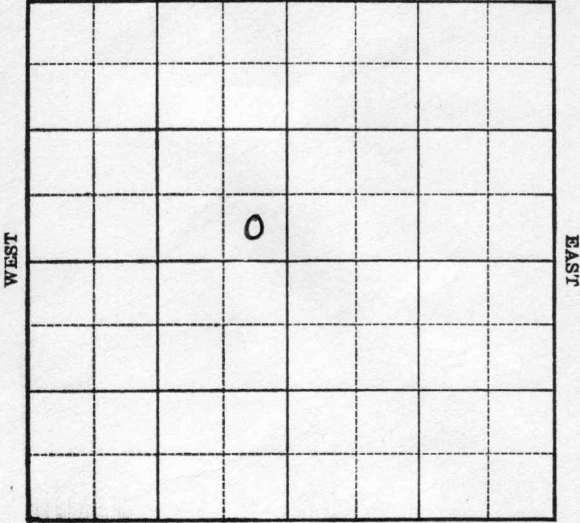

SOUTH

WEST

EAST

Sec. 23 Twp. 15 R. 14-W

Well No. #2 Resner Farm _____

Republic Natural Gas Company _____


(Trapp)

_____ Ft. from N. Line

330 Ft. from S. Line

330 Ft. from E. Line

_____ Ft. from W. Line

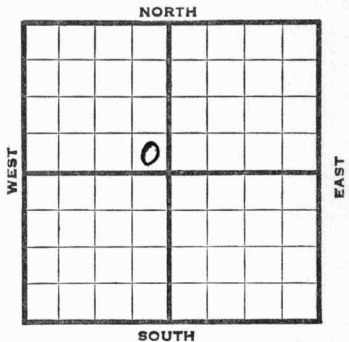

Elev. 1906'

| 1939 | REPORT |
|------|---------------------------------|
| 3/22 | Drlg. 2225' |
| 3/31 | 10" - 437' Anhy 905' |
| | Lans. 3100' Drlg. 3306' |
| 4/7 | Arb. 3356' 7" - 3355' |
| | T. D. 3364' 1½ bbls. oil per hr |
| | 1000 acid. H.F.O. |
| 4/14 | Testing. |
| 4/21 | Reacidized 1000 gals. |
| 4/28 | 2900 acid. Testing. |
| | |
| 5/3 | Arbuckle 3356' |
| | 7" - 3355' |
| | T. D. 3364' |
| | 4900 acid. |
| | Minimum well |
| | 15 bbls. |
| | |
| | COMPLETED |
| | |
| | |
| | |

Russell **KANSAS**

Map No. 73 Sec. 23 Twp. 15 R. 14W

Well No. 2 Resner

Republic Natural Gas Company

Contractor

FIRST REPORT

SECTION PLAT

SE NW

_____ Ft. from N. Line

330 Ft. from S. Line

330 Ft. from E. Line

_____ Ft. from W. Line

| | | | |
|--|--|--|--|
| | | | |
| | | | |
| | | | |
| | | | |
| | | | |

TRAPP POOL

Location _____

Rig up _____

Drilling and Remarks:

Drlg. 2225

RECORD

Cased _____ in., _____ ft.

Sand _____

Gas _____

Oil _____

Total Depth _____

PRODUCTION

1st 24 hrs. Nat. _____

1st 24 hrs. after shot _____

Gas _____ Cu. Ft.

Dry Hole _____

Abandoned _____

Date

MAR 22 1939

H. D. Hatfield Scout

Russell KANSAS

Map No. 73 Sec. 23 Twp. 15 R. 14 ~~W~~

Well No. #2 Resner

Republic Nat'l Gas. Company

Contractor

Trapp Pool

SECTION PLAT

| | | | |
|--|--|---|--|
| | | | |
| | | 0 | |
| | | | |
| | | | |

_____ Ft. from N. Line

330 Ft. from S. Line

330 Ft. from E. Line

_____ Ft. from W. Line

COMPLETED

Location _____

Rig up _____

Drilling and Remarks:

Artuckle 3356

7" @ 3355

4900 acid

Minimum Well

15 Bx 4

RECORD

Cased _____ in., _____ ft.

Sand _____

Gas _____

Oil _____

Total Depth 3364

PRODUCTION

• 1st 24 hrs. Nat. _____

1st 24 hrs. after shot _____

Gas _____ Cu. Ft.

Dry Hole _____

Abandoned _____

Date

MAY 3 1939 19

S. J. LEWIS Scout