

Section 12 Township 34 Range 3EWell No. #1 BocastowCompany Crest Petroleum

NORTH

SOUTH

WEST

EAST

13

0

Cowley

KANSAS

Sec. 12 Twp. 34 R. 3E

Well No. #1 Bocastow Farm

Crest Petroleum Company

Crest Petr. Contractor


Ft. from N. Line

330 Ft. from S. Line

Ft. from E. Line

990 Ft. from W. Line

SW $\frac{1}{4}$ SE SW SW

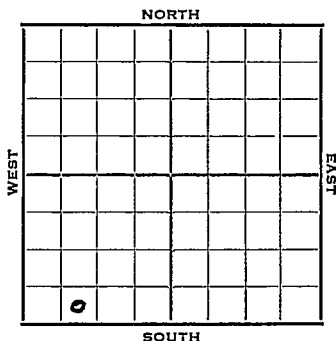

1952

Elev. 1150' REPORT

10/22

RUR

1953
1/23

Spud 10-23-52 Oil well TD 3390
8" @ 71 KC 2830'
DST 3360-90 open 1 hr. rec 370' oil
300' wtr. 990# 5" @ 3390
Miss 3388 TD 3390 Bart 3360'
20/3360-65 5 BO 2 $\frac{1}{2}$ BWPH
P2 BOPH 1 BW
Comp. 15 BOPD

COMPLETED

County Cowley State Kansas

Sec. **12** (Blk. **34** (Sur. **3E** Map No.

Operator **Grest Petroleum**

Well No. 1 Farm Bocastow

Elev.	Location	SE	SW	SW
-------	----------	----	----	----

~~FIRST REPORT~~

330 Ft. From S Line SW

990 Ft. From W Line Quarter

1st. Report OCT 22 1952

Completion

Remarks

Crest Pet. - Contr.


Spudding Date

Drlg. Data

R U R

J. G. McGEHEE

County Cowley State Kansas
 Sec. 12 (Blk.) 34 (Sur.) 3E Map No.
 Operator Crest Petroleum
 Well No. 1 Farm Bacastow
 Elev. 1150 Location SE SW SW

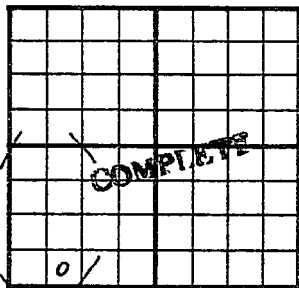

330 Ft. From S Line SW
990 Ft. From W Line Quarter

1st. Report

Completion JAN 23 1952

Remarks

Crest Pet. - Contr.

Spudding Date 10-23-52

Drig. Data Oil well TD 3390

8" @ 71 KC 2830 DST 3360-90

open 1 hr. Rec. 370' oil 300' wtr.

990# 5" @ 3390 Miss. 3388 TD 3390

Bart. 3360 20/ 3360-65 5 bo 2 $\frac{1}{2}$ bwph

P/ 2 boph 1 bw Comp. 15 bopd