


Section 12 Township 34 Range 3E

Well No. #1 Williams

Company Aylward Drlg.

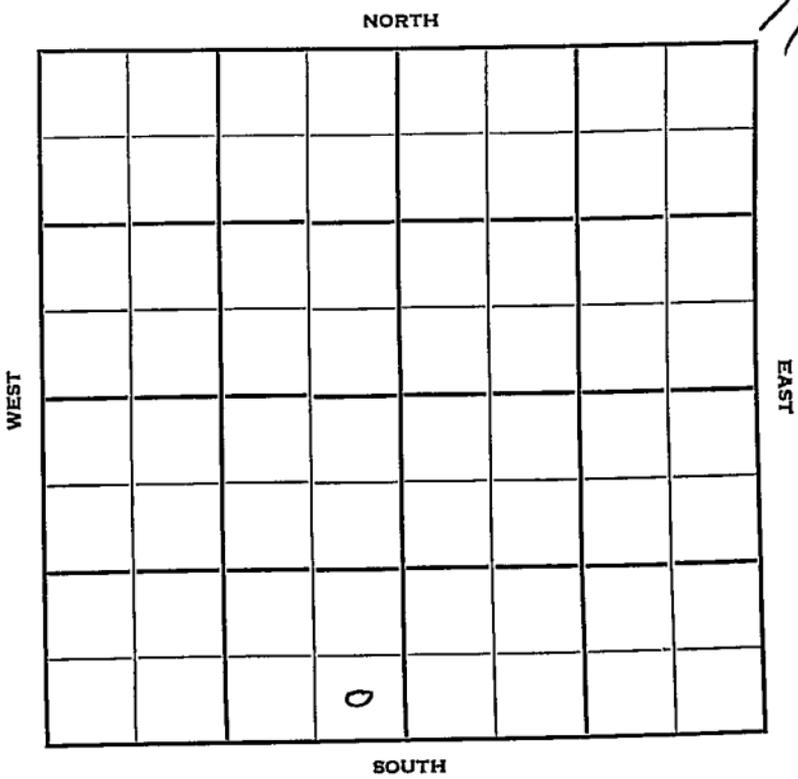

Cowley

KANSAS ✓

Sec. 12 Twp. 34 R. 3E

Well No. #1 Williams Farm

Aylward Drlg. Company

Contractor

E. Baird Pool


Ft. from N. Line

330 Ft. from S. Line

330 Ft. from E. Line

Ft. from W. Line

SW $\frac{1}{4}$ SE SE SW

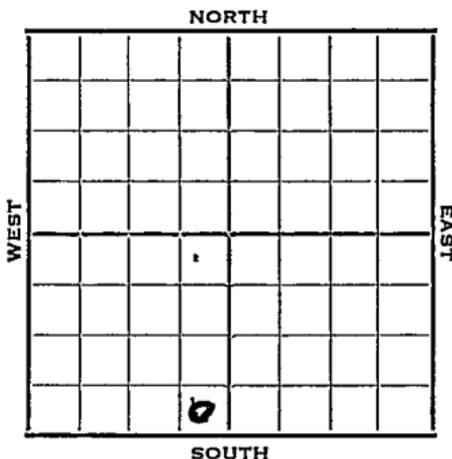

1952

Elev. 1170' REPORT

10/22
11/5

RUR
Spud 10-23-52
D&A TD 3416'
8" @ 96'
Layton 2664 KC 2841
Miss. 2390
TD 3416' D&A


ABANDONED

County Cowley State Kansas
 Sec. 12 (Blk. 34) (Sur. 3E) (Twp.) 3E Map No.

Operator Aylward Drlg.

Well No. 1 Farm Williams

Elev. 1170 Location SE SE SW

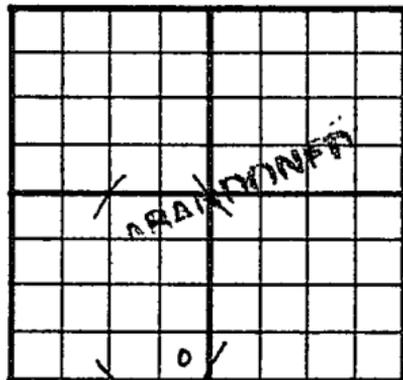

330 Ft. From S Line SW

330 Ft. From E Line Quarter

1st. Report

Completion NOV 5 1952

Remarks E. Baird Pool

Spudding Date 10-23-52

Drlg. Data D & A TD 3416

8" @ 96 Layton 2664 KC 2841

Miss. 2390 TD 3416

D & A

J. G. McGEHEE