

KANSAS


Russell

Form 51—5M—7-39—Palace

Section 23 Township 15 Range 14-W

Well No. #3 Resner

Company Republic Natural Gas

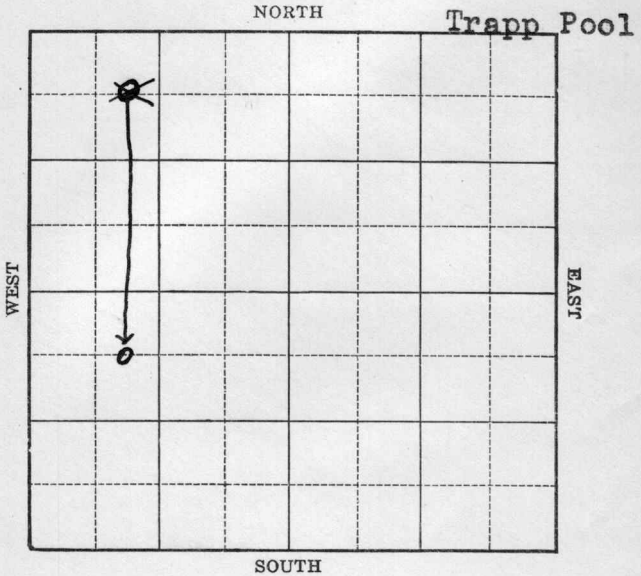

KANSAS

Russell

Sec. 23 Twp. 15 R. 14-WWell No. #3 Resner Farm

Republic Natural

Company

(Trapp)

660


Ft. from N. Line

Ft. from S. Line

Ft. from E. Line

990

Ft. from W. Line

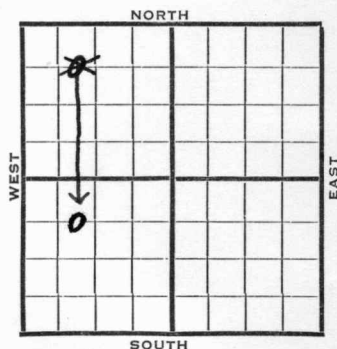

1940

REPORT

6/12

8" - 369'

Fishing 800'

6/20

Drlg. 2880'

6/27

Arb. 3329' 5" - 3329'

T.D. 3331' RUST.

7/3

T.D. 3335' 2700' oil 12 hours.

1000 acid.

7/11

6500 acid. Pump 82 bbls. 5 hrs.

7/18

" " " " " "

7/25

" " " " " "

8/2

" " " " " "

8/8

" " " " " "

8/14

" " " " " "

8/21

Arb. 3329'

5" - 3329'

T.D. 3335'

5500 acid.

Potential 243 bbls., pump.

COMPLETED

Form No. 200 Bks.—1-40—Palace Russell **KANSAS**

Map No. 73 Sec. 2 3 Twp. 15 R. 14W

Well No. 3 Resner

Republic Natural Gas Company

CORRECTION

Contractor

C E L NW NW

SECTION PLAT

660 Ft. from N. Line

 Ft. from S. Line

 Ft. from E. Line

990 Ft. from W. Line

TRAPP POOL

Location

Rig up

Drilling and Remarks:

Reported

C E L NW SW

RECORD

Cased in., ft.

Sand

Gas

Oil

Total Depth

PRODUCTION

1st 24 hrs. Nat.

1st 24 hrs. after shot

Gas Cu. Ft.

Dry Hole


Abandoned

Date

JUN 15 1940₁₉

S. J. LEWIS Scout

We show Cities Service drilled 2 wells in
SW/4. Should this well be in NW/4? Don.

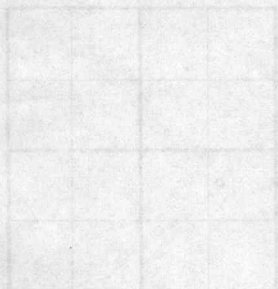

Misc. Small Map.....
Cards.....
Tracing.....
France Map.....
Scarborough Map.....
Moody Map.....
Geological Dept.
Moody Flat Book

Map No. _____ Sec. 23 Twp. 15 R. 14W

Well No. 3 Resner _____

Republic Natural _____ Company

Contractor _____

FIRST REPORT

C E L NW SW

660 Ft. from N. Line

_____ Ft. from S. Line

_____ Ft. from E. Line

990 Ft. from W. Line

SECTION PLAT

o			

TRAPP POOL

Location _____

Rig up _____

Drilling and Remarks:

8" - 369

Fishing 800'

RECORD

Cased _____ in., _____ ft.

Sand _____

Gas _____

Oil _____

Total Depth _____

PRODUCTION

1st 24 hrs. Nat. _____

1st 24 hrs. after shot _____

Gas _____ Cu. Ft.

Dry Hole _____

Abandoned _____

Date

JUN 12 1940 19

S. J. LEWIS Scout

We show Cities Service drilled 2 wells in
SW/4. Should this well be in NW/4?

Don Schumaker

Misc. Small Maps.....

Cards.....

Tracing.....

France Map.....

Scarborough Map.....

Moody Map.....

Geological Dept.

Moody Flat Book

Map No. 73 Sec. 23 Twp. 15 R. 14WWell No. 3 Resner

Republic Natural Gas Company


CORRECTION Contractor

C E L NW SW

660 Ft. from N. Line Ft. from S. Line Ft. from E. Line990 Ft. from W. Line

TRAPP POOL

SECTION PLAT

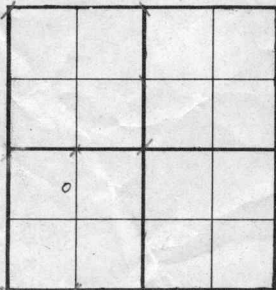Location Rig up

Drilling and Remarks:

Reported

C E L NW NW

RECORD

Cased in., ft.Sand Gas Oil Total Depth

PRODUCTION

1st 24 hrs. Nat. 1st 24 hrs. after shot Gas Cu. Ft.Dry Hole Abandoned

Date

JUN 26 1940 19S. J. LEWIS Scout

Ma No. _____ Sec. ²³~~25~~ Twp. 15 R. 14W

Well No. 3 Resner

Republic Natural Gas Company

CORRECTION

Contractor

C E L NW SW

660 Ft. from N. Line


_____ Ft. from S. Line

_____ Ft. from E. Line

990 Ft. from W. Line

TRAPP POOL

SECTION PLAT

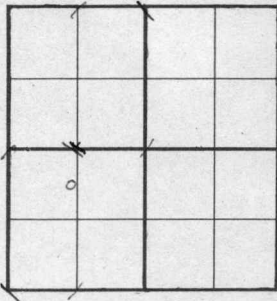

Location _____

Rig up _____

Drilling and Remarks:

E $\frac{1}{2}$ NW and W $\frac{1}{2}$ SW

Drill Site

RECORD

Cased _____ in., _____ ft.

Sand _____

Gas _____

Oil _____

Total Depth _____

PRODUCTION

1st 24 hrs. Nat. _____

1st 24 hrs. after shot _____

Gas _____ Cu. Ft.

Dry Hole _____

Abandoned _____

Date

JUN 29 1940

19

S. J. LEWIS Scout

Map No. _____ Sec. 23 Twp. 15 R. 14WWell No. 3 Resner

Republic Natural Gas Company

Contractor

COMPLETED

C E L NW SW

660 Ft. from N. Line

_____ Ft. from S. Line

_____ Ft. from E. Line

990 Ft. from W. Line

SECTION PLAT

0			

TRAPP POOL

Location _____

Rig up _____

Drilling and Remarks:

*CE X 3329**5" C 3329**5500 acid**Pump 243 P X.*

RECORD

Cased _____ in., _____ ft.

Sand _____

Gas _____

Oil _____

Total Depth 3335

PRODUCTION

1st 24 hrs. Nat. _____

1st 24 hrs. after shot _____

Gas _____ Cu. Ft.

Dry Hole _____

Abandoned _____

Date

AUG 21 1940 19

S. J. LEWIS Scout