
Rice

Form 51—5M—5-34—Palace

Map No. KANSAS Sec. 5 Twp. 18 R. 7 W

Well No. 1 Porter Farm

Elwell et al Company

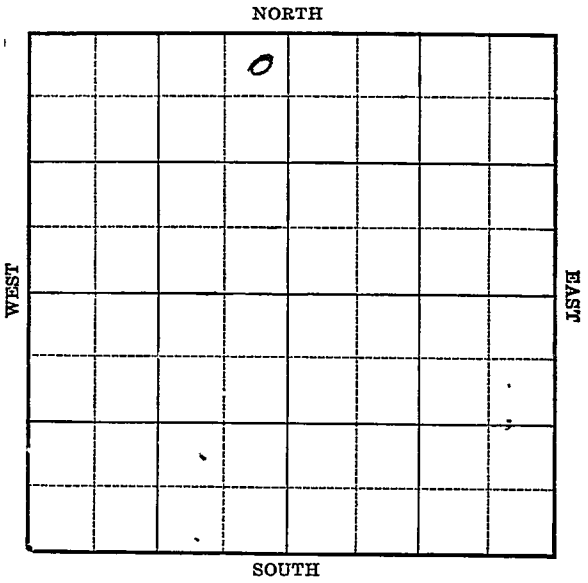

Location

Drilling Remarks

Rig Up

Drilling Remarks

RECORD

Cased ____ in. ____ ft.

Sand

Gas

Oil

Total Depth

PRODUCTION

1st 24 hrs. Nat.

1st 24 hrs. after shot

Gas ____ cu. ft.

Dry Hole

Abandoned

Rice

Form 252-A
5M 4-32 MPC

Map No. KANSAS Sec. 5 Twp. 18 R. 7 W

Well No. 1 Porter Farm


Elwell et al Company

330 Ft. from N. Line

_____ Ft. from S. Line

330 Ft. from E. Line

_____ Ft. from W. Line

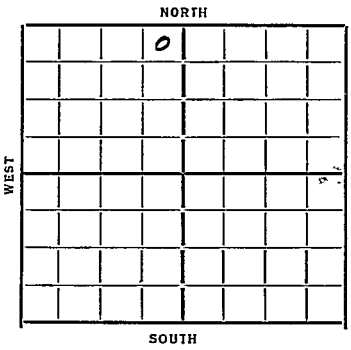

Date 1934	REPORT	El. 1735
6/27	Location	
7/5	—	
7/12	Bldg. Rig	
7/19	RR	
7/26	SD 240	
8/2	15" 350 T Salt 765 Dly 985	
8/9	Dly 1405	15" 1470
8/16	" 2015	
8/23	" 2460	10" 2176
8/30	HFW 2740-45	K.C. 2810
	HFW 2925	Dly 2960
9/6	6" 3008	L.O. 3105-15
	L.O. 3139-43	B.K.C. line 3160
	T Conq 3160	Dly 3176
9/13	SD 3330	
9/19	Silicious 3440	TD 3452
	HFW DFA	
	ABANDONED	

Form 26—1M Bks.—2-29

KANSAS

Map No. 45 Sec. 5 Twp. 18 R. 7W


Well No. #1 Porter

Elwell etal Company

Contractor

FIRST REPORTS

SECTION PLAT

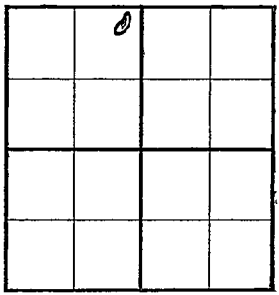

330 Ft. from N. Line

Ft. from S. Line

330 Ft. from E. Line

Ft. from W. Line

Location ✓

Rig up

Drilling and Remarks:

RECORD

Cased in., ft.

Sand

Gas

Oil

Total Depth

PRODUCTION

1st 24 hrs. Nat.

1st 24 hrs. after shot

Gas Cu. Ft.

Dry Hole

Abandoned

Date

6-27-34 19

ORVAL MANNSCHRECK Scout

Form 26—1M Blk—9-28

KANSAS

Map No. 45 Sec. 5 Twp. 18 R. 7W


Well No. 1—Porter

Elwell etal Company

Contractor

ABANDONED

SECTION PLAT

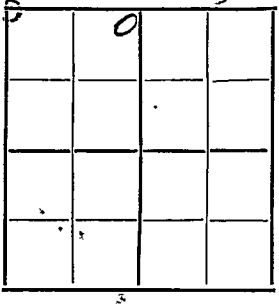

330 Ft. from N. Line

Ft. from S. Line

330 Ft. from E. Line

Ft. from W. Line

SPECIAL

Location

Rig up

Drilling and Remarks:

H F W

10 + F

RECORD

Cased in., ft.

Sand Shinnes 3470

Gas

Oil

Total Depth 3452

PRODUCTION

1st 24 hrs. Nat.

1st 24 hrs. after shot

Gas Cu. Ft.

Dry Hole

Abandoned

Date 9-19-37, 192

ORVAL MANNSCHRECK Scout