


Section 7 Township 18 Range 7 W

Well No. # 2 Wood

Company J. C. Dozier

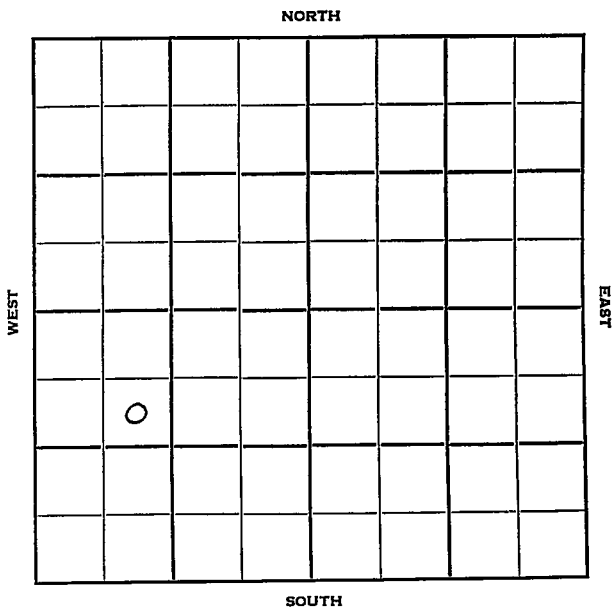

Rice

KANSAS ✓

Sec. 7 Twp. 18 R. 7 W

Well No. # 2 Wood Farm

J. C. Dozier Company

Stagg Drlg. - Contr. Contractor


990 Ft. from N. Line

_____ Ft. from S. Line

_____ Ft. from E. Line

990 Ft. from W. Line

SE NW SW

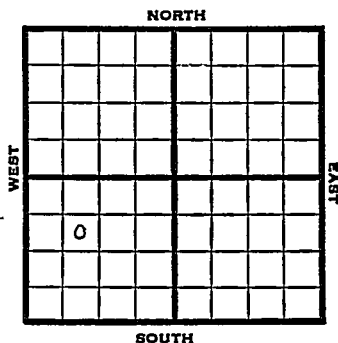

1951 Elev. 1700' REPORT

5/2 Location

5/29 Spud 5-1-51
 D&A TD 3234
 8" @ 205
 Heeb. 2633 Br Lime 2761
 Lans. 2789 Cong. 3156
 Kinderhook 3201
 Viola 3231
 5" @ 3233' TD 3234
 Perf/3183-3201 30 qt/3183-3201
 SP 3195 Perf/3170-81 S/8 bw 1 boph
 D&A **ABANDONED**

