

KANSAS


Rice

FORM 51 5M PETROL

Section 3 Township 18 Range 7W

Well No. #1 Graver

Company Phillips

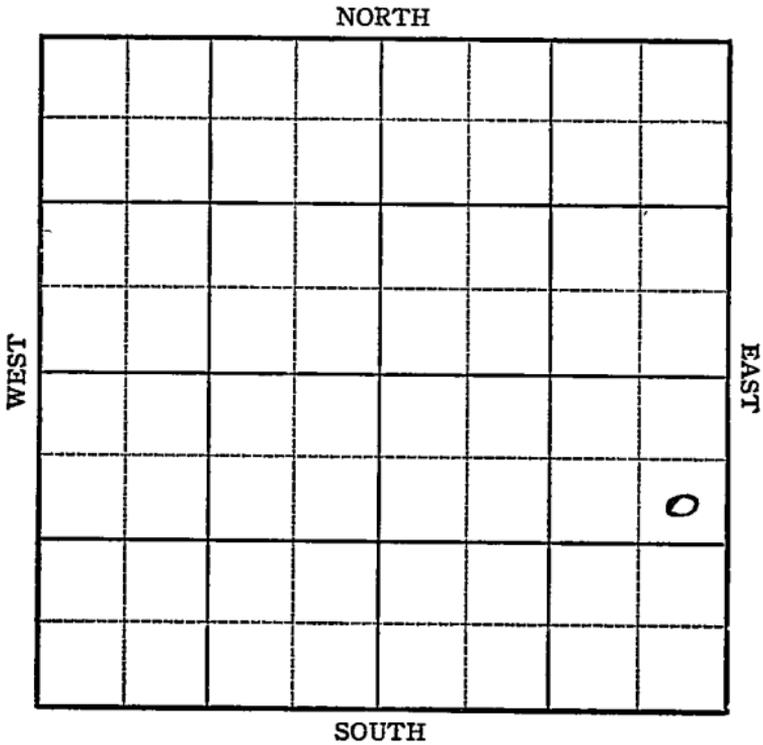

Rice

Sec. 3 Twp. 18 R. 7W

Well No. #1 Craver Farm

Phillips Company

Wildcat


990 Ft. from N. Line

_____ Ft. from S. Line

330 Ft. from E. Line

_____ Ft. from W. Line

4lev. 1692

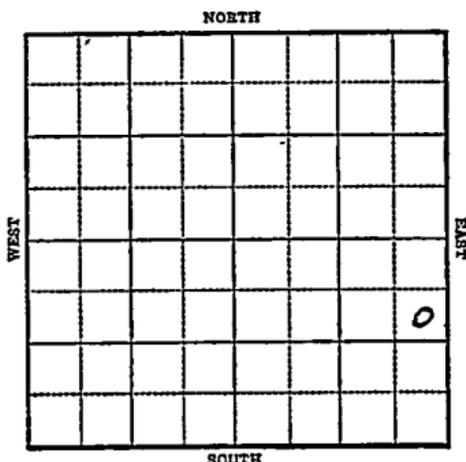

1944

R E P O R T

2/16	Location
2/23	Roatgry
3/1	8" @ 402 Drlg. 1610'
3/8	Lans 2732 Drlg. 2965
3/16	B K.C. 3091 Miss. 3163 Misener 3175-75 TD Sat. 5" @ 3175 Rust
3/22	" "
3/29	" "
4/5	500 acid no heat Drlg. 3230 500' water.
4/12	" "
4/19	" "
4/26	" "
5/3	" "
5/10	" "

OVER

1944

5/17

Misener 3175

5" - 3175

Total Depth 3230

ABANDONED

KANSAS
Map No. 45 Sec. 3 Twp. 18 R. 7W

Well No. 1 Craver

Phillips Company

FIRST REPORT Contractor

SE NE SE


SECTION PLAT

990 Ft. from N. Line

_____ Ft. from S. Line

330 Ft. from E. Line

_____ Ft. from W. Line

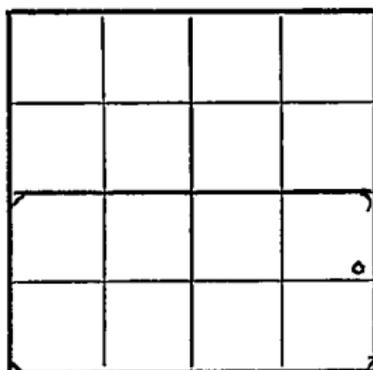

Wildcat

Location X

Rig up _____

Drilling and Remarks:

RECORD

Cased _____ in., _____ ft.

Sand _____

Gas _____

Oil _____

Total Depth _____

PRODUCTION.

1st 24 hrs. Nat. _____

1st 24 hrs. after shot _____

Gas _____ Cu. Ft.

Dry Hole _____

Abandoned _____

Date

FEB 16 1944 19

S. J. LEWIS Scout

KANSAS

Pool Name Wildcat

Map No. 45 Sec. 3 Twp. 18 R. 7W

Well No. 1 Craver

Phillips Company

ABANDONED Contractor

SE NE SE

SECTION PLAT

990 Ft. from N. Line

_____ Ft. from S. Line

330 Ft. from E. Line

_____ Ft. from W. Line

			0

Rice County

RECORD

Location _____

Rig up _____

Drilling and Remarks:

Miner 3175
5" 3175

Cased _____ in., _____ ft.

Sand _____

Gas _____

Oil _____

Total Depth 9230

PRODUCTION

1st 24 hrs. Nat. _____

1st 24 hrs. after shot _____

Gas _____ Cu. Ft.

Dry Hole _____

Abandoned _____

Date

MAY 17 1944 19

S. J. LEWIS Scout