


Map No. KANSAS Sec. 4 Twp. 18 R. 7-W
 Well No. #1 Roghe Farm
Continental Etal Company

NORTH

WEST

EAST

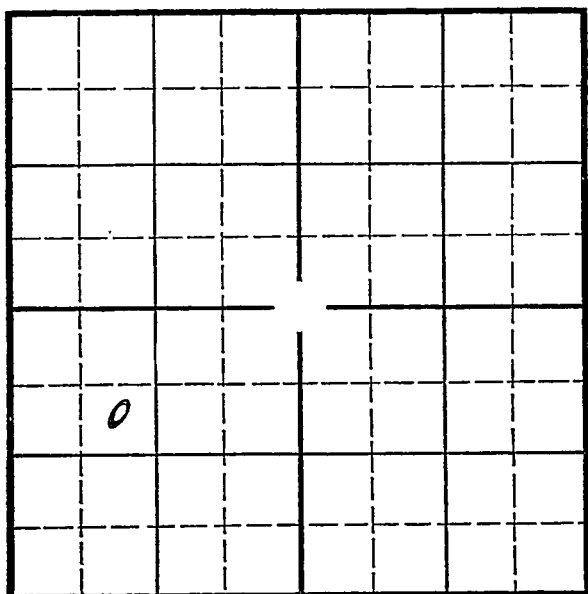

SOUTH

Location _____
 Drilling Remarks _____

Rig Up _____
 Drilling Remarks _____

RECORD

Cased _____ in. _____ ft.
 Sand _____
 Gas _____
 Oil _____
 Total Depth _____

PRODUCTION

1st 24 hrs. Nat. _____
 1st 24 hrs. after shot _____
 Gas _____ cu. ft. _____
 Dry Hole _____
 Abandoned _____

KANSAS

Map No. _____ Sec. 4 Twp. 18 R. 7-W

Well No. 1-Roche Farm _____

Continental et al

Company


990 Ft. from N. Line

_____ Ft. from S. Line

_____ Ft. from E. Line

990 Ft. from W. Line

Elev. 1721

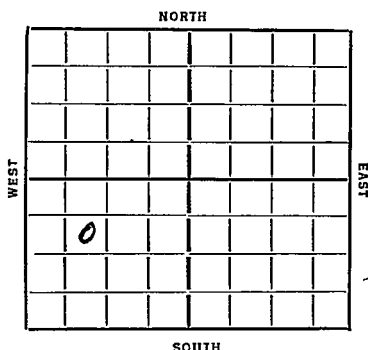

Date
1936

REPORT

3/25 Location

4/2 Rign.

4/10 188' S.D.

4/16 Drlg. 2950'

4/22/36- Sil. 3317'

T.D. 3338'

Water. D & A

ABANDONED

KANSAS

Map No. 45 Sec. 4 Twp. 18 R. 34Well No. 1 RocheContinental & Co. Company

Contractor

SECTION PLAT

990 Ft. from N. Line

Ft. from S. Line

Ft. from E. Line

990 Ft. from W. Line

FIRST REPORTS

Location ✓

Rig up

Drilling and Remarks:

RECORD

Cased in., ft.Sand Gas Oil Total Depth

PRODUCTION

1st 24 hrs. Nat. 1st 24 hrs. after shot Gas Cu. Ft.Dry Hole Abandoned

Date

3/25/96 192 S. J. LEWIS Scout

KANSAS

Map No. 45 Sec. 4 Twp. 18 R. 24Well No. 1 Roche.Continental Company


Contractor

SECTION PLAT

990 Ft. from N. Line

Ft. from S. Line

Ft. from E. Line

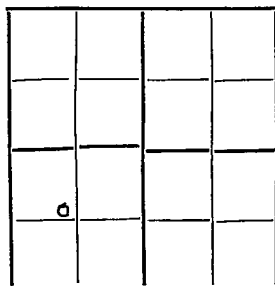990 Ft. from W. Line

ABANDONED

Location

Rig up

Drilling and Remarks:

Sil 8317waterDVA

RECORD

Cased _____ in., _____ ft.

Sand _____

Gas _____

Oil _____

Total Depth 3938

PRODUCTION

1st 24 hrs. Nat. _____

1st 24 hrs. after shot _____

Gas _____ Cu. Ft.

Dry Hole _____

Abandoned _____

Date

APR. 22 1936

192

S. J. LEWIS

Scout