

26-10-25E
 Plot
 Jm

WELL LOG BUREAU - KANSAS GEOLOGICAL SOCIETY

UNION NATIONAL BANK BLDG. WICHITA, KANSAS

Location NWcSW

Sec. 26T. 10 R. 25E

Casing Record
 10" Farm- Airport No. 9
 20" 8 1/2" Company- Fairfax Airport Corp.
 15 1/8" 65/8" Contr.-
 12 3/8" 53/16" Comm.- 6-14-29 Comp.- 7-3-29
 Total Depth 522 Shot Quarts Between
 Correspondence Regarding This Well Should Be Referred to

County- Wyandotte.



Elevation East 738

Figures Indicate Bottom of Formations.
 6-7-30

Initial Production Dry.

Lawnee
 35'
Lex.

soil and sand	109
shale	135
sdv shale	149
red rock	155
lime and shale	166
sdv shale	184
lime	190
sdv shale show gas	203
sand sh gas	207
shale	209
sdv shale	217
<i>br lime - 217</i>	225
shale	235
lime sdv	252
<i>lime - top 252</i>	255
lime and shale	280
sand	294
sand	298
shale	305
shale sdv	385
shale	420
red rock	425
shale	435
sdv shale	465
shells	480
sdv shale	497
shells	502
sand	522 TD.
Trace blue shale below bottom hole.	
Sand	

60 Fms near sand 60
 49 Coarse " " 109
 26 Sand grey shale 131
 14 Light sandy shale 149
 6 Red bed 151
 11 Heavy shale 166
 8 Light blue sandy shale 179

10 grey sandy shale 180
 6 grey ls 190

13 light sandy shale 203 *Brachiopods & grs*
 4 Sand 201 *little grs*

2 Dark slate 209

8 grey sandy shale 217

8 Brown ls 225

10 light shale 231

17 Dark heavy shale 252

3 Black ls 255

25 light heavy shale 270

10 grey shale 290

4 light shale 294

4 Sand 298

7 Dark shale 305

32 1/2 grey sandy shale 337

6 Blue sandy shale 343

2 grey " " 341

9 " " " 344

6 Red sandy shale 360

5 grey sandy shale 361

20 Dark grey sandy shale 385

5 Blue shale 390

10 Black shale 400

15 Blue shale 415

5 grey shale 420

5 Red bed 425

10 grey shale 435

30 light sandy shale 465

15 Dark shale
 lime brks 450


15 light sandy shale 495

R. C. Kears
 Dry hole

Fairfax Reports Corp

Sec 26 Tr 10S 25E

Map No. 9

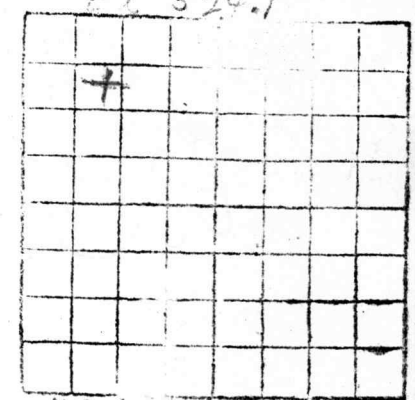

4260 f SL
 900 f WL
 324.1
 413.5
 737.6 elev
 250
 486

2 Blue sandy shale 497
 5 Dark shale &
 heavy shales 502
 20 Sand 522 TD
 (1000 y blue shale under sand)

Farm R. C. Kears Land Co.