

KANSAS

Rice


Form 51-5M-7-39-Palace

Section 7 Township 18 Range 7-W

Well No. #4 Lewis

Company Derby Oil

NORTH Geneseo Pool

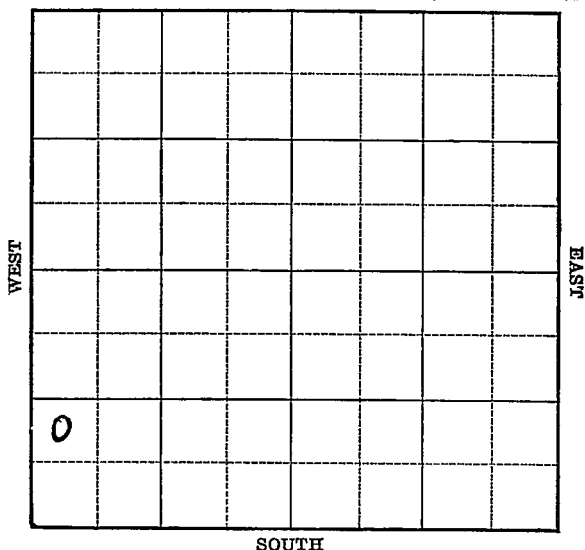

Map No. 45 Sec. 7 Twp. 18 R. 7WWell No. 4 LewisDerby Oil

Company

Contractor

FIRST REPORT

NW SW SW

Ft. from N. Line

990

Ft. from S. Line

Ft. from E. Line

330

Ft. from W. Line

SECTION PLAT

o			

GENESEO POOL

Location

Rig up

Drilling and Remarks:

Rotary

RECORD

Cased _____ in., _____ ft.

Sand _____

Gas _____

Oil _____

Total Depth _____

PRODUCTION

1st 24 hrs. Nat. _____

1st 24 hrs. after shot _____

Gas _____ Cu. Ft.

Dry Hole _____

Abandoned _____

Date

NOV 15 1939 19

S. J. LEWIS Scout

Rice

KANSAS

Map No. 45 Sec. 7 Twp. 18 R. 7WWell No. 4 LewisDerby Oil

Company

Contractor

COMPLETED

NW SW SW

SECTION PLAT

o			

Ft. from N. Line

990

Ft. from S. Line

Ft. from E. Line

330

Ft. from W. Line

GENESEO POOL

Location

RECORD

Cased _____ in., _____ ft.

Sand _____

Gas _____

Oil _____

Total Depth 3233**PRODUCTION**

1st 24 hrs. Nat. _____

1st 24 hrs. after shot _____

Gas _____ Cu. Ft.

Dry Hole _____

Abandoned _____

Location

Rig up

Drilling and Remarks:

Cr 832314 "C 3231158 1/2

Date

DEC 13 1939 19

S. J. LEWIS Scout