


Section 8 Township 18 Range 7W

Well No. #2 Ferguson

Company B & B Drlg.

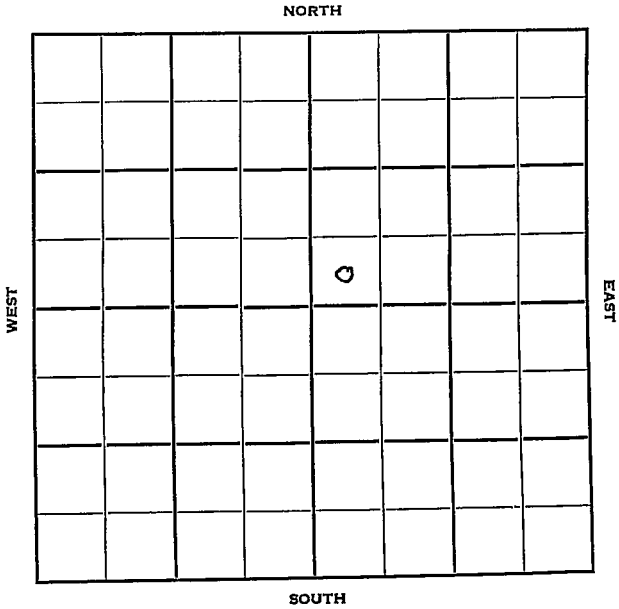

Sec. 8 Twp. 18 R. 7 W

Well No. # 2 Ferguson Farm

B & B Drlg. Company

B & B Drlg. Contractor


Ft. from N. Line

330 Ft. from S. Line

Ft. from E. Line

330 Ft. from W. Line

SW SW NE

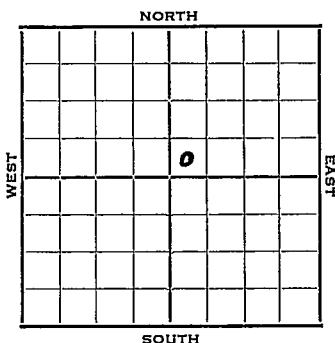

1952	Elev. 1712' REPORT
9/24	Cellar & Pits
10/1	8" @ 244 Drlg. 2601'
10/8	Heeb 2609, Br L 2732, Lans 2764 DST 3141-56, 45 mins., 90 O&GCM & 350' oil Arb 3207 TD 3215 5" @ 3209'
10/15	CO to 3215 POP
10/22	NR
10/29	P/28 BOPD
11/5	NR
11/12	Spud 9-24-52 Oil Well TD 3215' 8" @ 244 Heeb. 2609, Br. lime 2732', Lans. 2764 DST 3141-56, opn 45 mins., Rec. 90' o & gcm, 350' oil, Arb. 3207' TD 3215 5" @ 3209' CO to 3215' P/28 bopd Comp. 132 bopd COMPLETED

