


Section 24 Township 29 Range 5E

Well No. #5 Hader

Company McBride et al

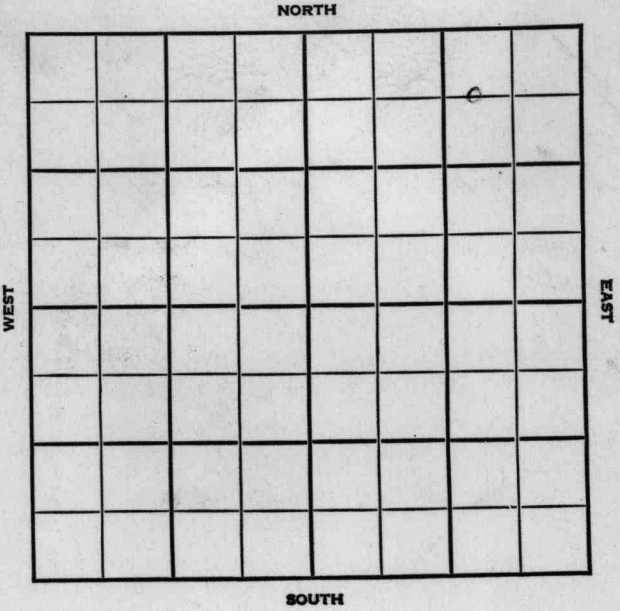



Sec. 24 Twp. 29 R. 5E

Well No. #5 Hader Farm

McBride et al Company


Misc.

660 Ft. from N. Line

_____ Ft. from S. Line

990 Ft. from E. Line

_____ Ft. from W. Line

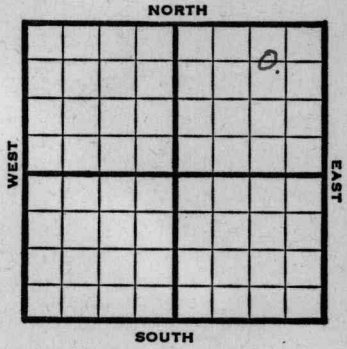

© W L NE NE

1947 Elev. 1365' REPORT

- 11/19 10" @ 102'
Drlg. 1000'
- 11/25 Drlg. 2580'
- 12/3 Bart. 2817'
TD 2834'
7" @ 2871'
RUST
- 12/10 "
- 12/17 80 qts. 2817-34'
CO
- 12/30 "
- 1948
1/7 "
- 1/14 Bart. 2817'
7" @ 2811'
80 qts.
Pump 25 Pot
38.0 Gr.
TD 2834'
Comp.

COMPLETED

Map No. _____ Sec. 24 Twp. 29 R. 5E

Well No. 5 Hader

McBride etal. Company

FIRST REPORT

Contractor

C W L NE NE

SECTION PLAT

660 Ft. from N. Line

_____ Ft. from S. Line

990 Ft. from E. Line

_____ Ft. from W. Line

| | | | |
|--|--|--|---|
| | | | 0 |
| | | | |
| | | | |
| | | | |

Butler County

Location _____

Rig up _____

Drilling and Remarks:

10" @ 102

drlg. 1000

RECORD

Cased _____ in., _____ ft.

Sand _____

Gas _____

Oil _____

Total Depth _____

PRODUCTION

1st 24 hrs. Nat. _____

1st 24 hrs. after shot _____

Gas _____ Cu. Ft.

Dry Hole _____

Abandoned _____

Date

NOV 19 1947 19

S. J. LEWIS

Scout

Map No. 11 Sec. 24 Twp. 29 R. 5E

Well No. 5 Hader

McBride etal. Company

COMPLETE

Contractor

C W L NE NE

E11365

SECTION PLAT

660 Ft. from N. Line

_____ Ft. from S. Line

990 Ft. from E. Line

_____ Ft. from W. Line

| | | | |
|--|--|--|---|
| | | | 4 |
| | | | |
| | | | |
| | | | |

Butler County

Location _____

Rig up _____

Drilling and Remarks:

Bar 2577

7" @ 2571

509 to.

Pump 2508

380 lb

RECORD

Cased _____ in., _____ ft.

Sand _____

Gas _____

Oil _____

Total Depth 2834

PRODUCTION

1st 24 hrs. Nat. _____

1st 24 hrs. after shot _____

Gas _____ Cu. Ft.

Dry Hole _____

Abandoned _____

Date

JAN 14 1948 19

S. J. LEWIS Scout