

Butler


FORM 51 IOM 12-46 PETROL **KANSAS**

Section 24 Township 29 Range 5-E

Well No. #1 Hader

Company McBride etal

Miscellaneous

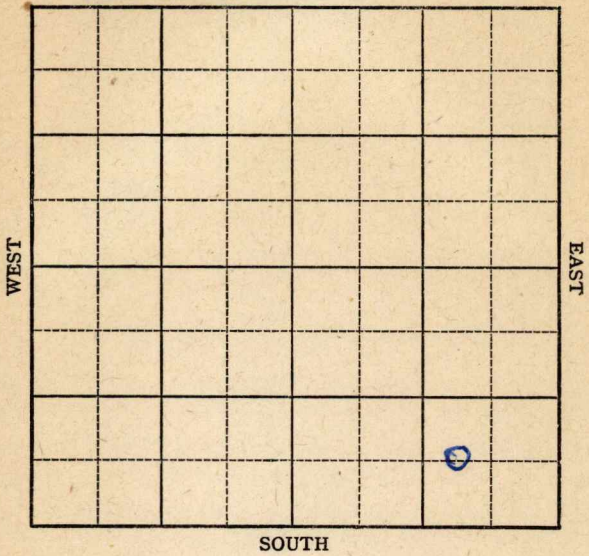

Sec. 24 Twp. 29 R. 5-E

Well No. 1 Hader Farm

McBride et al. Company

Miscellaneous


Ft. from N. Line

660 Ft. from S. Line

990 Ft. from E. Line

Ft. from W. Line

C WL SE SE

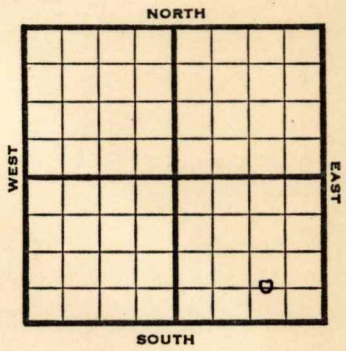

1947	<b>Elev. 1350'</b> REPORT
8/20	Loc.
8/27	10" @ 128' Drlg. 1925'
9/3	<b>Bart. 2778'</b> TD 2800' 7" @ 2767'
9/10	"
9/17	<b>Bart. 2778'</b> 7" @ 2767' 100 qts Pump 50 Pot Gr. 39° Total Depth 2807'
	<b>COMPLETED</b>

Kansas

Map No. \_\_\_\_\_ Sec. 24 Twp. 29 R. 5E

Well No. 1 Hader

McBride etal. Company

**FIRST REPORT**

Contractor

C W L SE SE

**SECTION PLAT**

			o

\_\_\_\_\_ Ft. from N. Line

660 Ft. from S. Line

990 Ft. from E. Line

\_\_\_\_\_ Ft. from W. Line

Butler County

Location X

Rig up \_\_\_\_\_

Drilling and Remarks:

**RECORD**

Cased \_\_\_\_\_ in., \_\_\_\_\_ ft.

Sand \_\_\_\_\_

Gas \_\_\_\_\_

Oil \_\_\_\_\_

Total Depth \_\_\_\_\_

**PRODUCTION**

1st 24 hrs. Nat. \_\_\_\_\_

1st 24 hrs. after shot \_\_\_\_\_

Gas \_\_\_\_\_ Cu. Ft.

Dry Hole \_\_\_\_\_

Abandoned \_\_\_\_\_

Date

AUG 20 1947

19

S. J. LEWIS

Scout

Map No. 11 Sec. 24 Twp. 29 R. 5E

Well No. 1 Hader

McBride etal. Company

**COMPLETE** Contractor

C W L SE SE

*E. 1. 1850*

**SECTION PLAT**

         Ft. from N. Line

660 Ft. from S. Line

990 Ft. from E. Line

         Ft. from W. Line


Butler County

Location         

Rig up         

Drilling and Remarks:

*Bar Y 2775*  
*7' @ 2767*  
*100 gts*  
*Pump 58 RT*  
*299-44*

**RECORD**

Cased          in.,          ft.

Sand         

Gas         

Oil         

Total Depth 2507

**PRODUCTION**

1st 24 hrs. Nat.         

1st 24 hrs. after shot         

Gas          Cu. Ft.

Dry Hole         

Abandoned         

Date

SEP 17 1947 19

S. J. LEWIS Scout