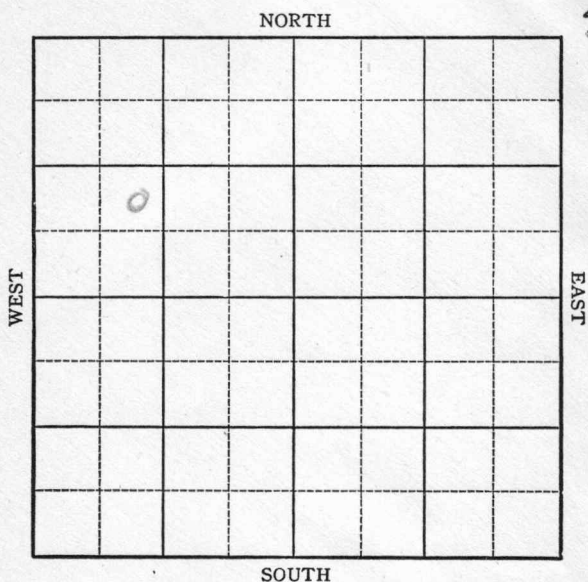


KANSAS Russell county

Section 24 Township 15 Range 14-WWell No. #9, Krug "A"Company Cities Service Oil Company

KANSAS

Russell

Sec. 24 Twp. 15 R. 14W

Well No. #9 Krug "A" Farm

Cities Service Company


Trapp

 Ft. from N. Line

990 Ft. from S. Line

 Ft. from E. Line

990 Ft. from W. Line

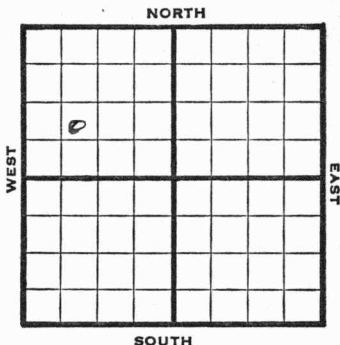

NE SW NW

1946

Elev. 1911' REPORT

10/16 Location

10/22 8" @ 342'

Drlg 2050'

10/29 Arb 3359-62 TD

4" @ 3361, RUST

11/6 Lans 3111'

11/12 TD 3368'

Pump 88 oil in 11 hrs.

11/20 Arb 3359'

4" @ 3361'

TD 3368'

Pump 234 Pot

40 Grav.

COMPLETED

KANSAS

Map No. 73 Sec. 24 Twp. 15 R. 14W

Well No. 9 Krug "A"

Cities Service

Company

FIRST REPORT

Contractor

NE SW NW

SECTION PLAT

0			

Ft. from N. Line

990 Ft. from S. Line

Ft. from E. Line

990 Ft. from W. Line

Russell County

Location X

Rig up

Drilling and Remarks:

RECORD

Cased _____ in., _____ ft.

Sand _____

Gas _____

Oil _____

Total Depth _____

PRODUCTION

1st 24 hrs. Nat. _____

1st 24 hrs. after shot _____

Gas _____ Cu. Ft.

Dry Hole _____

Abandoned _____

Date

OCT 16 1946 19

S. J. LEWIS Scout

~~Kansas~~ KANSAS

Trapp Pool

Map No. 23 Sec. 24 Twp. 15 R. 14WWell No. 9 Krug "A"

Cities Service

Company

COMPLETED

Contractor

NE SW NW

E. 1911
SECTION PLAT

0			

Ft. from N. Line

990 Ft. from S. Line

Ft. from E. Line

990 Ft. from W. Line

Russell County

Location

Rig up

Drilling and Remarks:

*Per 10057**4" @ 3361**Run 204 ft**40 ft*

RECORD

Cased _____ in., _____ ft.

Sand _____

Gas _____

Oil _____

Total Depth *3361*

PRODUCTION

1st 24 hrs. Nat. _____

1st 24 hrs. after shot _____

Gas _____ Cu. Ft.

Dry Hole _____

Abandoned _____

Date

NOV 20 1946 19

S. J. LEWIS

Scout