


Section 10 Township 18 Range 7W

Well No. #1 Click

Company Murfin Drlg.

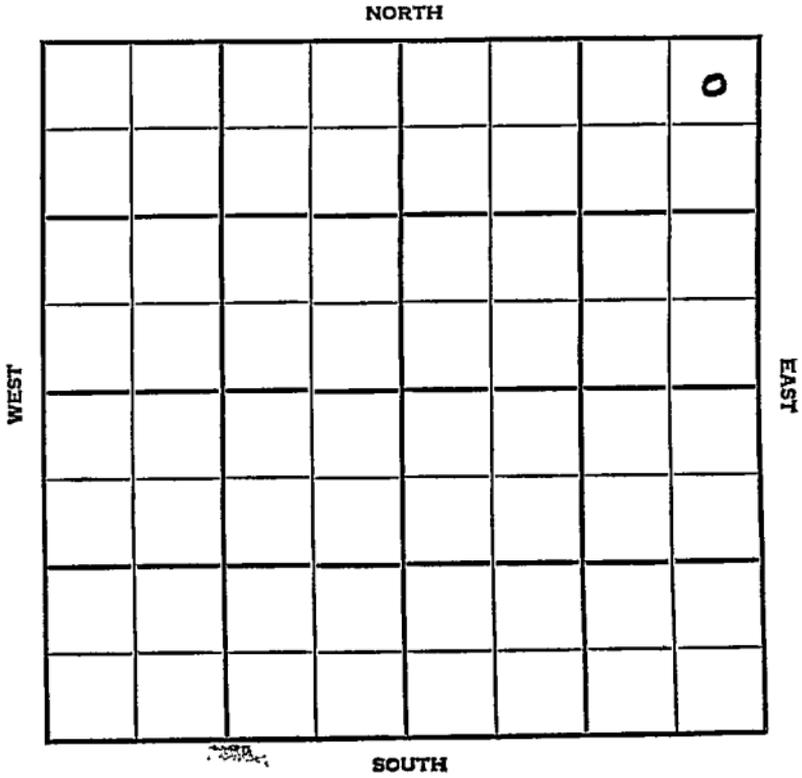

Rice KANSAS

SEC.	TWP.	R.
10	18	7W

WELL NO. **1 Click** FARM

COMPANY

CONTRACTOR **Murfin Drlg.**

Lewis Drlg.
SE Click Pool


330 Ft. from N. Line

_____ Ft. from S. Line

330 Ft. from E. Line

_____ Ft. from W. Line

NE NE NE

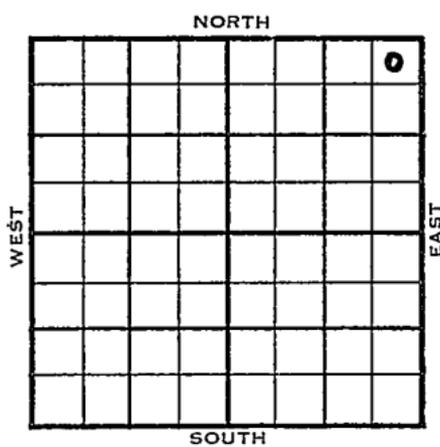

	ELEVATION	REPORT
1955	1688'	

4/6 Spud 4-1-55
8" @ 190'

4/13 Drlg. 2300'
Spud 4-1-55 D & A TD 3195
8" @ 190' eeb 2562' Tor. 2582'
Doug 2601 Br. lime 2681 Lans 2711
DST 2793-2813, open 1 hr rec 225' MW
DST 3042-64 open 1/2 hr rec 5' mud 0#
Ch. Cong. 3131' Sd cong 3142'
DST 3141-46 open 45 min, rec 15' mud 0#.
DST 3146-53 open 1 hr rec 180' gas, 360' oil & wtr 480' wtr. 910#
Kh. 3163 Misener 3172'
DST 3173-85 open 1 hr, rec 550' wtr. 985# TD 3195' D & A

ABANDONED

County Rice State Kansas

Sec. 10 (Blk. Twp.) 18 (Sur. Rge.) 7W Map No.

Operator Murpin Drlg.

Well No. 1 Farm Click

Elev. Location NE NE NE

330 Ft. From N Line NE

330 Ft. From E Line Quarter

Ist. Report APR 6 1955

Completion

Remarks

Lewis Drlg. - Contr.

Spudding Date 4-1-55

Drlg. Data SE Click Pool

8" @ 190 drlg. 2300

County Rice State Kansas

Sec. 10 (Blk. 18) (Sur. Rge.) 7W Map No.

Operator Murfin Drlg.

Well No. 1 Farm Click

Elev. 1688 Location NE NE NE

330 Ft. From N Line NE

330 Ft. From E Line Quarter

Ist. Report

Completion APR 13 1955

Remarks SE Click Pool

Lewis Drlg. - Contr.

Spudding Date 4-1-55

Drlg. Data D & A TD 3195

8" @ 190 Heeb. 2562 Tor. 2582

Doug. 2601 Br. lime 2681 Lens. 2711

DST 2793-2813 open 1 hr. Rec. 225' mw

DST 3042-64 open $\frac{1}{2}$ hr. Rec. 5' mud

0# Ch. Cong. 3131 Sd. Cong. 3142

DST 3141-46 open 45 min. Rec. 15' mud

0# DST 3146-53 open 1 hr. Rec. 180'

gas 360' oil & wtr. 480' wtr. 910#

Kh. 3163 Misener 3172 DST 3173-85

open 1 hr. Rec. 550' wtr. 985#

TD 3195

D & A

FABEN GILSTRAP