


Section 22 Township 15 Range 14-W

Well No. #7 Korat

Company Lee Phillips Oil

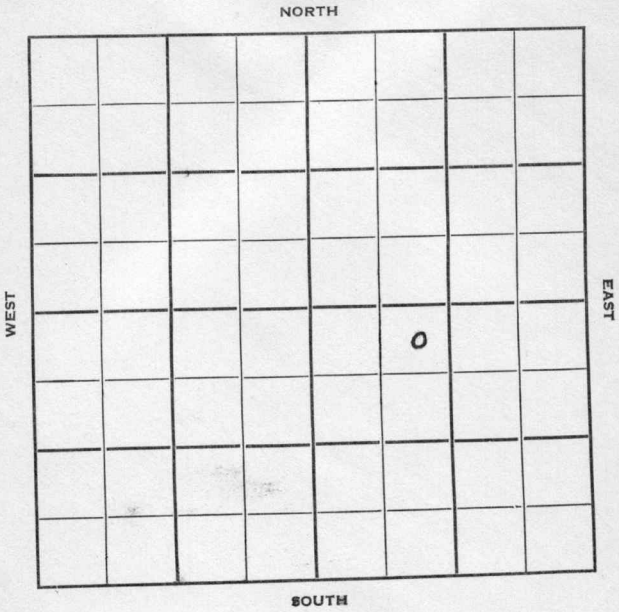

Sec. 22 Twp. 15 R. 14-W ✓

Well No. #7 Korst Farm _____

Lee Phillips Oil Company _____

Contractor _____


Trapp
330 Ft. from N. Line

_____ Ft. from S. Line

_____ Ft. from E. Line

990 Ft. from W. Line

NE NW SE

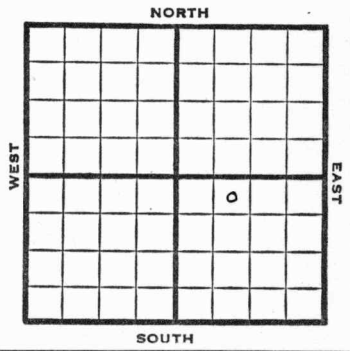

1950

Elev. 1861' **REPORT**

11/8

RUR

12/13

Spud 11-8-50
 Oil Well TD 3305
 8-5/8" @ 517' Anhy 875-915
 TD 3305 5" @ 3302
 Arb. 3302 S/7 boph
 Comp. 100 bopd

COMPLETED

