

Rice

KANSAS


SECTION 10 TOWNSHIP 18S RANGE 7W

WELL NO. #1-Brucker

COMPANY Cherry Drlg.

NE NE SE

NORTH

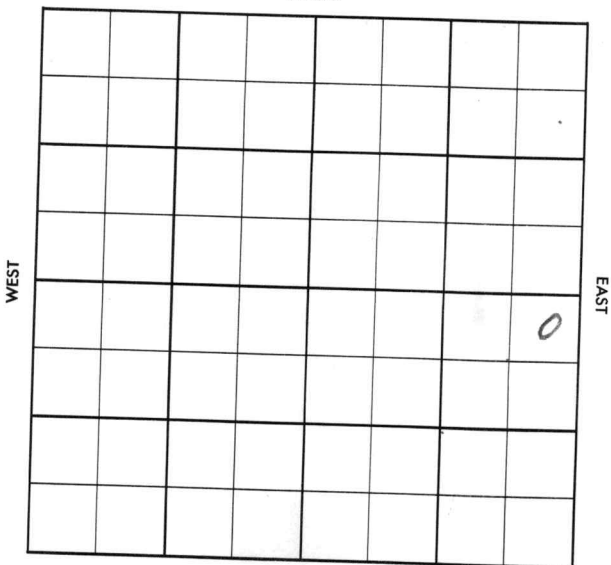

SOUTH

WILDCAT

County Rice Elev. _____
 Sec. 10 Twp. 18 Rgs. 7W
 Company Cherry Drilg.
 Farm Name Brucker No. 1

TOPS	DEPTH	LOG	DATUM
Anh.			
Tr.			
H.			
Tr.			
Dg.			
B.L.			
L.			
K.C.			
B.K.C.			
Ce.			
C.			
M.			
M.			
K.			
Mz.			
Mq.			
V.			
S.			
S.			
A			
R.			
Pf.			
G.			
T.D.			

Loc. in Sec. NE NE SE
 Geol. _____
 Contr. _____
Co. tools
 Pool Wildcat

FIRST REPORT
 JUL 7 '57

Date Comm. M I R

~~12~~

Co. Lse. No. Sec. T. R.

County Rice Elev. 1697
 Sec. 10 Twp. 18 Rgs. 7W
 Company Cherry Bell
 Farm Name Brucker No. 1

TOPS	DEPTH	LOG	DATUM
Anh.			
TP.			
H.	<u>2578</u>		
Tr.	<u>2607</u>		
Dg.			
Bl.	<u>2699</u>		
L.	<u>2734</u>		
K.C.			
B.K.C.	<u>3088</u>		
Ce. <u>sd</u>	<u>3148-56</u>		
C.			
M.			
M.			
K.			
Mz. <u>sd</u>	<u>3188</u>		
Ma.			
V.			
S.			
S.			
A.			
R.			
PE.			
G.			
TD.	<u>3194</u>		

Loc. in Sec. _____
 NE NW SE
 Geol. _____
 Contr. _____
 Co. tools _____
 Pool _____
 Wildcat _____
ABANDONED
 JUL 31 '57

Date Comm. M T R AL 24 57 7-17-57 858 206
1135 D 2905 JUL 31 57 D 47 3140
-53 1hr 1590' SW BHT 790/20"
DST 3188-94 1hr 1345' SW
BHT 1105/20"
D & A

Co.
 Sec.
 No.
 Sec.
 T.
 R.