


Section 11 Township 18 Range 7W

Well No. 1 Newkirk


Company Derby Oil

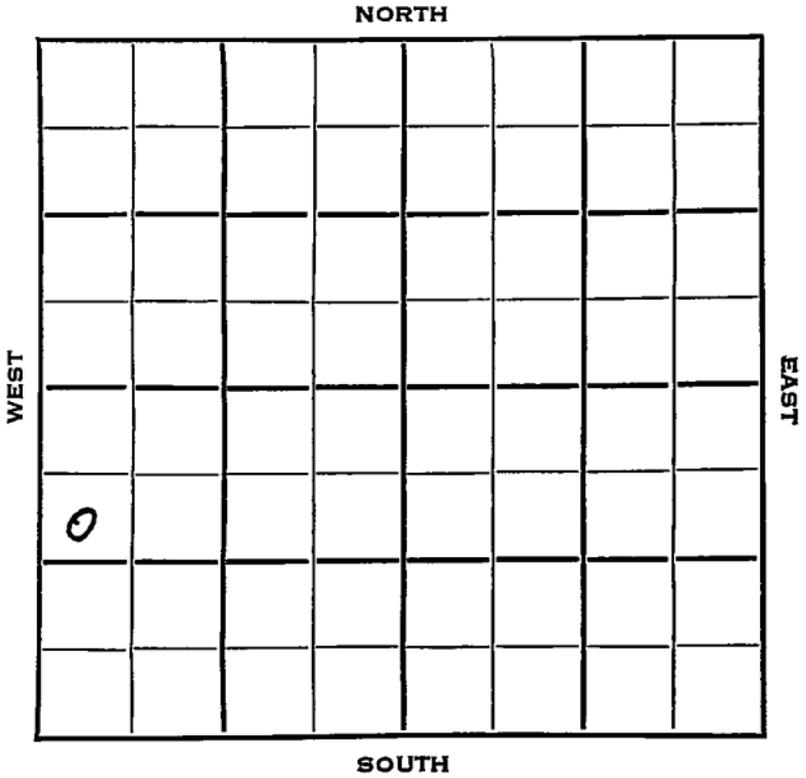

Rice KANSAS

SEC.	TWP.	R.
11	18	7W ✓
WELL NO		
1 Newkirk		FARM
COMPANY		
Derby Oil		
CONTRACTOR		
Peel		

990 _____ Ft. from N. Line
 _____ Ft. from S. Line
 _____ Ft. from E. Line
 330 _____ Ft. from W. Line
 SW NW SW

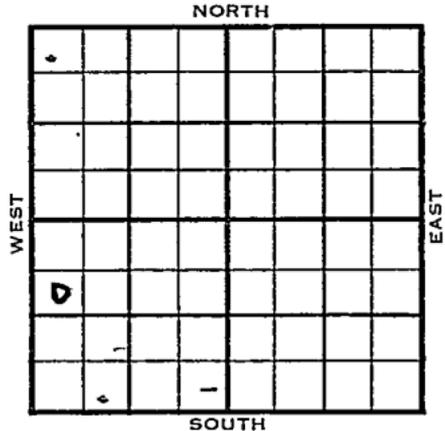

1954	ELEVATION	REPORT
	1688'	
1/13	MIR	
1/20	8" @ 258' w/150 sks Dr1g. 2970'	
1/27	Br li 2689', Lans 2724', B KC 3076', Cong 3130' DST 3131-45', 1/2 hrs., 1020' gas, 165' hocm, 15' gree oil, 860# KH 3160', Meisner 3178' DST 3180-85', 1 hr., 210' sw, 975# Mq sha 3224', Mq dol 3228' DTD 3238 5" @ 3234'	
2/3	15/3145-48, 20 gwph + scum oil 30/3134-40, 57 go + 26 gwph SP 3143 7 goph 250A S/52 bw 1 1/4 hrs., sq. 48/3134-42, B/30 gw + 3 1/2 go 1st hr., B/3 gw + 20 ? go 5th, 250A S/43 BW + scum oil, sq.	

OVER

1954
2/10

Spud 1-12-54 D & A TD 3235
8" @ 258 Br. lime 2689 Lans 2724
B KC 3076 Cong. 3130
DST 3131-45 open $\frac{1}{2}$ hr rec 1020' gas,
165' HOCM, 15' free oil 860#
Kh. 3160 Meisner 3178
DST 3180-85 open 1 hr rec 210' SW
975# Maq. sh. 3224 Maq. dol. 3228
TD 3235 5" @ 3234 15/3145-48
20 GWPH scum oil 30/3134-40 57 GO
26 GWPH SP 3141 7 GOPH 250 A
S/52 BW $1\frac{1}{4}$ hr. 48/3134-42
B/30 GW $3\frac{1}{2}$ GO 1 hr. B/3 GW 20 GO
5 hr. 250 A S/43 BW scum oil
48/3131-42 17 GO 3 GW 14 hr.
oil-frac. S/30 BSWPH
D & A

ABANDONED

County Rice State Kansas

Sec. 11 (Blk. Twp.) 18 (Sur. Rge.) 7W Map No.

Operator Derby Oil

Well No. 1 Farm Newkirk

Elev. 1688 Location SW NW SW

990 Ft. From N Line SW

330 Ft. From W Line Quarter

1st. Report

Completion FEB 10 1954

Remarks Wildcat

Peel - Contr.

Spudding Date 1-22-54

Drlg. Data D & A TD 3235

8" @ 258 Br. lime 2689 Lans. 2724

B KC 3076 Cong. 3130 DST 3131-45

open 1/2 hr. Rec. 1020' gas 165' hocom

15' free oil 860# Kh. 3160 Meisner

3178 DST 3180-85 open 1 hr. Rec. 210'

sw 975# Maq. sh. 3224 Maq. dol. 3228

TD 3235 5" @ 3234 15/ 3145-48

20 gwph scum oil 30/ 3134-40

57 go 26 gwph SP 3141-47 goph 250 A

S/ 52 bw 1 1/4 hr. 48/ 3134-42

B/ 30 gw 3 1/2 go 1 hr. B/ 3 gw 20 go 5 hr

250 A S/ 43 bw scum oil 48/ 3131-42

17 go 3 gw 14 hr. oil-frac S/ 30 bswph

D & A

J. G. McGEHEE