

KANSAS


Russell County

FORM 51 5M PETROL

Section 22 Township 15 Range 14W

Well No. 3 Oaks

Company Phil-Han

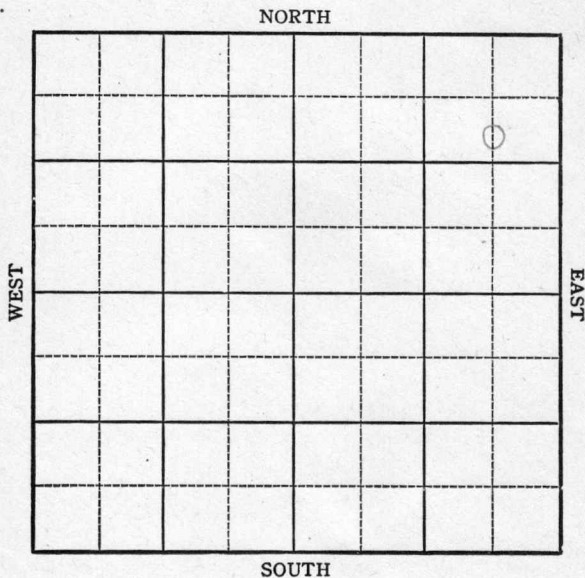

KANSAS

Russell

Sec. 22 Twp. 15 R. 14W

Well No. 3 Oaks Farm

Phil-Han Company

Trapp

990


Ft. from N. Line

Ft. from S. Line

660

Ft. from E. Line

Ft. from W. Line

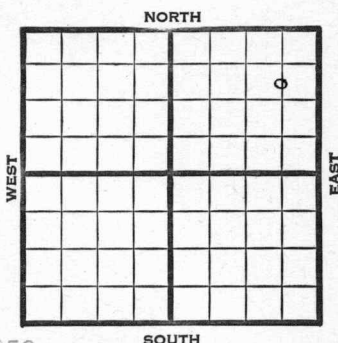

C S L NE NE Elev. 1859

1945

REPORT

5/23

SH

5/31

8" @ 630

Drlg. 2832

6/8

Arb. 3298 TD 3303 5" @ 3300

RUST

6/14

TD 3306

2000 Oil 6 hrs

6/21

" " "

6/28

" " "

7/11

Arb. 3298

5" @ 3300

2000 acid.

TD 3306'

Pump 236 Pot.

Grav. 40.9

COMPLETED

Kansas Pool Name TrappMap No. 73 Sec. 22 Twp. 15 R. 14WWell No. 3 OaksPhil-Han CompanyFIRST REPORT Contractor

C S L N E N E

SECTION PLAT

990 Ft. from N. Line Ft. from S. Line660 Ft. from E. Line Ft. from W. Line

			o

RussellLocation Rig up Drilling and Remarks:
SH

RECORD

Cased in., ft.Sand Gas Oil Total Depth

PRODUCTION

1st 24 hrs. Nat. 1st 24 hrs. after shot Gas Cu. Ft.Dry Hole Abandoned

Date

MAY 23 194519S. J. LEWISScout

KANSAS Kansas Pool Name TrappMap No. 73 Sec. 22 Twp. 15 R. 14WWell No. 3 OcksPhil-an

Company

COMPLETED

Contractor


C S L NE NE

E 11839
SECTION PLAT990 Ft. from N. Line

Ft. from S. Line

660 Ft. from E. Line

Ft. from W. Line

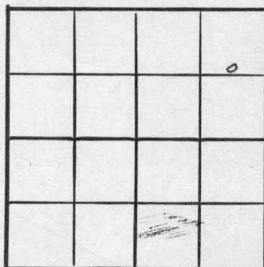

Russell County

Location

Rig up

Drilling and Remarks:

Ar 432985" C 33002000 acidPump 236 Pst40 1/2 G

RECORD

Cased _____ in., _____ ft.

Sand _____

Gas _____

Oil _____

Total Depth 3306

PRODUCTION

1st 24 hrs. Nat. _____

1st 24 hrs. after shot _____

Gas _____ Cu. Ft.

Dry Hole _____

Abandoned _____

Date

JUL 11 1945

19

S. J. LEWIS Scout