


Section 24 Township 29 Range 5E

Well No. 9 Haver

Company McBride et al

Misc.

NORTH

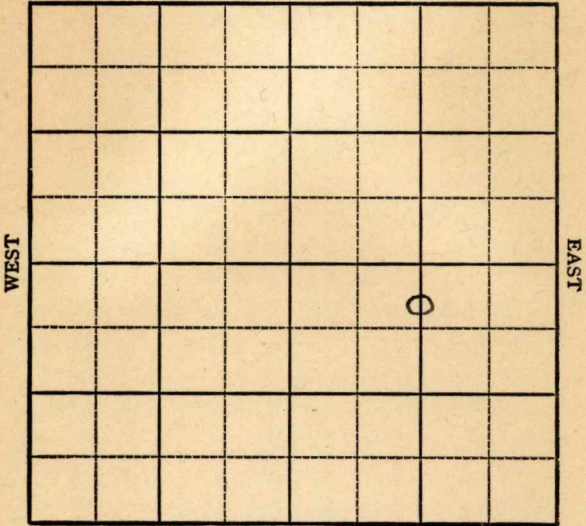

SOUTH

KANSAS

Butler

Sec. 24 Twp. \_\_\_\_\_ R. 5E ✓

Well No. #9 Haver Farm \_\_\_\_\_

McBride et al Company \_\_\_\_\_

Miscellaneous


\_\_\_\_\_ Ft. from N. Line

1900' Ft. from S. Line

1300' Ft. from E. Line

\_\_\_\_\_ Ft. from W. Line

C N $\frac{1}{2}$  SE

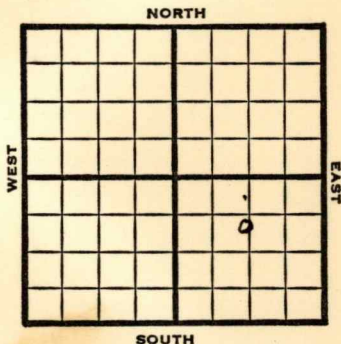

1949

Elev. 1363 REPORT

2/2 Location

2/9 Location

2/16 "

2/23 Bart 2777'

10" @ 104'

Miss 2814'

TD 2815'

7" @ 2769'

3/2 "

3/8 30 qts 2779-2809'

Swb 11 bbls oil / 109 W 24 hrs.

3/16 "

3/23 "

3/30 Miss 2874'

Bart 2777'

7" @ 2769'

30 qts 2779-2809'

Pump 11 oil & 109 W Pot.

Gr. 38°

TD 2815'

COMPLETED

Map No. \_\_\_\_\_ Sec. 24 Twp. 29 R. 5E


Well No. 9 Haver

McBride etal. Company

**FIRST REPORT** Contractor

C  $N\frac{1}{2}$  SE

**SECTION PLAT**

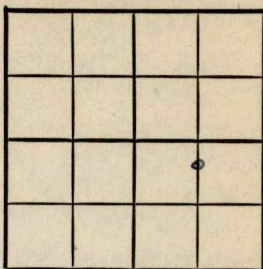

\_\_\_\_\_ Ft. from N. Line

1900 Ft. from S. Line

1300 Ft. from E. Line

\_\_\_\_\_ Ft. from W. Line

Butler County

Location X

Rig up \_\_\_\_\_

Drilling and Remarks:

**RECORD**

Cased \_\_\_\_\_ in., \_\_\_\_\_ ft.

Sand \_\_\_\_\_

Gas \_\_\_\_\_

Oil \_\_\_\_\_

Total Depth \_\_\_\_\_

**PRODUCTION**

1st 24 hrs. Nat. \_\_\_\_\_

1st 24 hrs. after shot \_\_\_\_\_

Gas \_\_\_\_\_ Cu. Ft.

Dry Hole \_\_\_\_\_

Abandoned \_\_\_\_\_

Date

FEB 2 1949 19

S. J. LEWIS Scout

Kansas

5E

Map No. 11 Sec. 24 Twp. 29 R.         

Well No. 9 Haver

McBride et al. Company

**COMPLETE** Contractor

C N  $\frac{1}{2}$  SE

*E 11363*

**SECTION PLAT**

         Ft. from N. Line

1900 Ft. from S. Line

1300 Ft. from E. Line

660  
7960 Ft. from W. Line


Butler County

Location         

Rig up         

Drilling and Remarks:

*Miss 2574*  
*Bar 2777*  
*7" O 2769*  
*30 Sept 2775-2805*  
*Prod 11 oil + 109K*  
*RX 2805*

**RECORD**

Cased          in.,          ft.

Sand         

Gas         

Oil         

Total Depth 2825'

**PRODUCTION**

1st 24 hrs. Nat.         

1st 24 hrs. after shot         

Gas          Cu. Ft.

Dry Hole         

Abandoned         

Date

MAR 30 1949 19

S. J. LEWIS

Scout