

Rice

KANSAS

Section 11 Township 18 Range 7W

Well No. #1 Newkirk

Company Isern Bros.

NORTH

	0						

WEST

EAST

SOUTH

Rice

Sec. 11 Twp. 18 R. 7^W

Well No. #1 Newkirk Farm

Isern Bros. Company

Contractor


Click

330 Ft. from N. Line

_____ Ft. from S. Line

_____ Ft. from E. Line

990 Ft. from W. Line

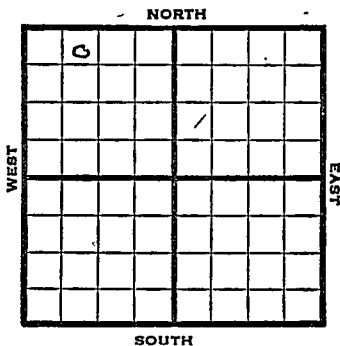

NE NW NW

Phillips FO

1952

Elev. 1681' REPORT

1/23

Location

2/6

TD 3181'
5" @ 3176' POP

2/13

No report

2/20

"

3/5

"

3/12

Spud 1-23-52
Oil Well TD 3181
8" @220
Anhy 290-318 Heeb. 2552
Tor. 2573 B. Oread 2592
Br Lime 2669 Lans. 2703
DST 3037-52 opn 20 min
Rec. 250' hocm BKC 3069
Cong. 3130
DST 3150-57 opn 1 hr. Rec. 80' gcm
& SSO & 180' sw TD 3181
5"@ 3176 GO to 3181 500' sw
SP 3095 20/3046-52 1/2 boph 1000 A
S/9 boph Comp. 48 bopd

COMPLETED

County Rice State Kansas

Sec. 11 (Bik. Twp.) 18 (Sur. Rge.) 7W Map No.

Operator Isern Bros.

Well No. 1 Farm Newkirk

Elev. _____ Location NE NW NW

a					

330 Ft. From N Line NW

990 Ft. From W Line Quarter

Ist. Report JAN 23 1952

Completion _____

Remarks Phillips - F.G.

Spudding Date _____

Drig. Data Click

Location

J. E. TYRA

County Rice State _____

Sec. 11 (Blk. Twp.) 18 (Sur. Rge.) 7W Map No. _____

Operator Isern Bros.

Well No. 1 Farm Newkirk

Elev. 1681 Location NE NW NW

o					

COMPLETE

330 Ft. From N Line NW

990 Ft. From W Line Quarter

1st. Report

Completion MAR 1 2 1952

Remarks Click Pool

Spudding Date 1-23-52

Drlg. Data Oil well TD 3181

8" @ 220 Anhy 290-318 Heeb. 2552

Tor. 2573 B. Oread 2592 Br. lime 2669

Lans. 2703 DST 3037-52 open 20 min.

Rec. 250' hocm B KC 3069 Cong. 3130

DST 3150-57 open 1 hr. Rec. 80' gem &

SSO & 180' ^{2nd}sw. TD 3181 5" @ 3176.

CO to 3181 500' sw SP 3095

20/ 3046-52 1/2 boph "1000" A S/ 9 boph

Comp. 48 boph