

Rice


DX 78-1

KANSAS

Section 11 Township 18 Range 7W

Well No. #1 Newkirk

Company Reed Dirgan & Paine

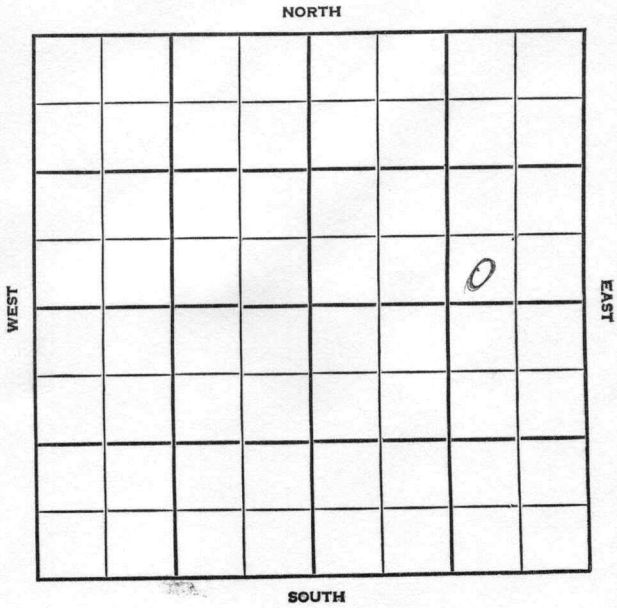

WILDCAT

County Rice Elev. _____ Co.
 Sec. 11 Twp. 18 Rge. 7W
 Company Reed Dirgan & Paine
 FarmName Newkirk No. 1

TOPS	DEPTH	LOG	DATUM	Loc. in Sec.
Anh.				SW SE NE
Tr.				
H.				
Tr.				
Dg.				
Bl.				
L.				Geol.
K.C.				Contr.
B.K.C.				Bennett & Roberts Tools
Ce.				Pool
C.				Semi WC
M.				
M.				
K.				
Mz.				
Mq.				
V.				
S.				
S.				
A.				
R.				
PE.				
G.				
T.D.				

Date Comm. spd. 11-19-56 Phillips FO & DHM
8" @ 223 w/150, WOC

12

County Rice Elev. 1686 Co.
 Sec. 11 Twp. 18 Rge. 7W
 Need Dirgan & Paine
 Newkirk No. 1

TOPS	DEPTH	LOG	DATUM	Loc. in Sec.
Anh.				SW SE NE
TP.				
H.	2558	2558		
Tr.		2585		
Dg. <u>sd</u>	2602	2599		
Bl.	2675	2676		
L.	2711	2711		Geol.
K.C.				
B.K.C.		2081		Contr.
Ce. <u>Martin</u>		2087		
C.	3143	3143		Bennett & Ro-
M.				berts Tools
M.				Pool
K.		3170		
Mz. <u>sd</u>	3200	3205		Semi WC
Mo.				
V. <u>chty LI</u>		3268		
S. <u>ery VIO</u>		3334		
S. <u>D610</u>		3373		
A.				
R.				
Pe.				
G.				
T.D.	3395			

COMPLETE
 DEC 26 '56
 1/4
 1/4

Date Comm. spd. 11-19-56 Phillips FO & DHM

8" @ 223 w/150, WOC NOV 28 '56 DST

3048-53
 3055-63 1hr rec 300' OCM BHP

80/20" DST 3145-65 1hr 6/22"

90 517 MCF rec 1020' 9554 oil

FP 200-500 BHP 900/20 DST

3202-15 1hr 60' 9554 Mdy wh

BHP 925 DST 3215-60 1hr

90' 50 CM + 120' MW + 20' BHP

1100/ 1/4 3260 DEC 5 '56 5 1/2 3395/100

RUCT CO DEC 12 '56 CO 16/3154-58
S 8.34 Boph no/w S.I. 16 hrs
FU 2400' oil DEC 19 '56 ✓ POP DEC 26 '56
P. 66 Bopd + 3% wtr