


Rice

KANSAS

SECTION 11 TOWNSHIP 18S RANGE 7W

WELL NO. #2 Newkirk

COMPANY Robert C. Vogt

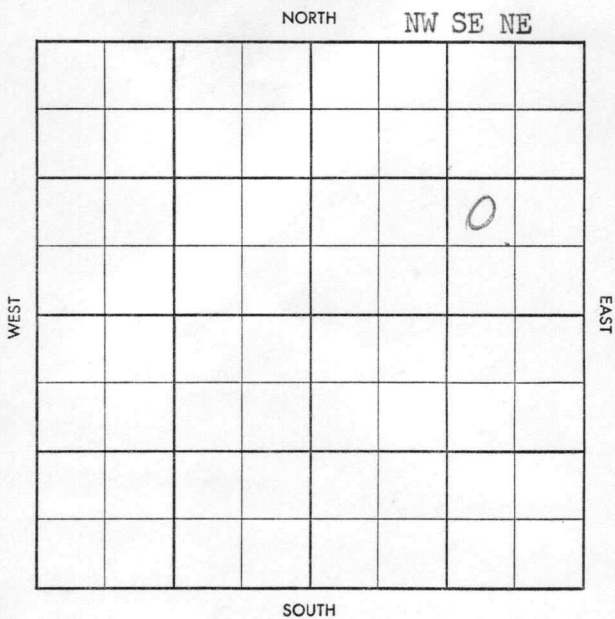

CO. Rice ELEV. 1694RB  
SEC. 11 TWP. 18 RGE. 7W  
COMPANY Robert C. Vogt NO. 2

ABANDONED  
FIRST REPORT  
JAN 2 '58

FARM NEWKIRK  
LOC. NW SE NE

Heeb	2572
Tor	2599
Doug sd	2617
B.L.	2689
KC	2724
BKC	3091
Cong Sd	3168
Mz sd	3225
RTD	3238

GEOL. Bill Richards  
CONTR. Sierra Drlg. #4  
POOL Click SE  
SPUD 12/18/57  
8" @ 225 w/150, tops.  
DST 3060-80/30, 30'  
OSPECM, bhp 0/20 .  
Ø 3158-80 full rec. DST  
3150-80/1 hr. 40' SLOCM  
BHP 360/20, DST 3226-

38/30 15' 0 spec M, BHP 870/15, RTD 3238.

D & A.

~~K-12~~

LSE.  
NO.  
SEC.  
TWP.  
RGE.