


Map No. KANSAS Sec. 23 Twp. 15 R. 14^w

Well No. 2-13 Bender Farm
Empire Oil & Gas Company

_____ Ft. from N. Line
330 Ft. from S. Line
990 Ft. from E. Line
_____ Ft. from W. Line

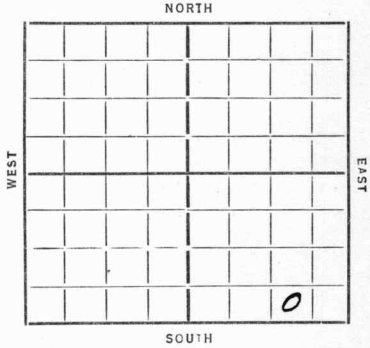

Date	REPORT
<u>1934</u>	
<u>9/5</u>	<u>Rig</u>
<u>9/15</u>	<u>Dlg 418 20" 20'</u>
<u>9/20</u>	<u>" 540</u>
<u>9/27</u>	<u>" 1470 12" 885</u>
<u>10/4</u>	<u>" 1980</u>
<u>10/11</u>	<u>" 2533</u>
<u>10/18</u>	<u>8 7/8 2660 2800 WR</u>
<u>10/25</u>	<u>8" 2800 6" 3165 A.O. & W. 3155-65</u>
	<u>Dlg 3215</u>
<u>11/1</u>	<u>Core 3325 T Siliceous 3349</u> <u>3350 T D</u>
<u>11/8</u>	<u>Core 6" 3349 P.B.P.</u>
<u>11/15</u>	<u>T D 3354 1700' oil 18 hrs.</u> <u>1000 acid</u>
<u>11/22</u>	<u>Taking potential</u>
<u>11/27</u>	<u>Siliceous 3349 T D 3354</u> <u>1000 acid 223 Bbls.</u>

COMPLETED

Map No. 73 Sec. 23 Twp. 15 R. 14W

Well No. 213 - Bended

Empire Oil & Gas Company,

Contractor

FIRST REPORTS

SECTION PLAT

_____ Ft. from N. Line

330 Ft. from S. Line

990 Ft. from E. Line

_____ Ft. from W. Line

			0

Location _____

Rig up _____

Drilling and Remarks:

Rig

RECORD

Cased _____ in., _____ ft.

Sand _____

Gas _____

Oil _____

Total Depth _____

PRODUCTION

1st 24 hrs. Nat. _____

1st 24 hrs. after shot _____

Gas _____ Cu. Ft.

Dry Hole _____

Abandoned _____

Date

9-5-37 19

Form 26 1M/Bks. 9-28 *Russell*

Map No. *73* Sec. *23* Twp. *15* R. *14 W*

Well No. *2B-Bender*

Empire oil

Company

Contractor

COMPLETED

SECTION PLAT

			0

..... Ft. from N. Line

330 Ft. from S. Line

990 Ft. from E. Line

..... Ft. from W. Line

RECORD

Location.....

Cased..... in., ft.

Rig up.....

Sand *siliceous 3349*

Drilling and Remarks:

Gas.....

1000 acid

Oil.....

Total Depth *3354*

PRODUCTION

223 bbls

1st 24 hrs. Nat.....

1st 24 hrs. after shot.....

Gas..... Cu. Ft.

Dry Hole.....

Abandoned.....

Date

11-27-37 192.....