Russell KANSAS


Form 51—5M—11-38—Palace

Section 23 Township 15 Range 14-W

Well No. 2 Bender "D"

Company Cities Service Oil

Trapp Pool

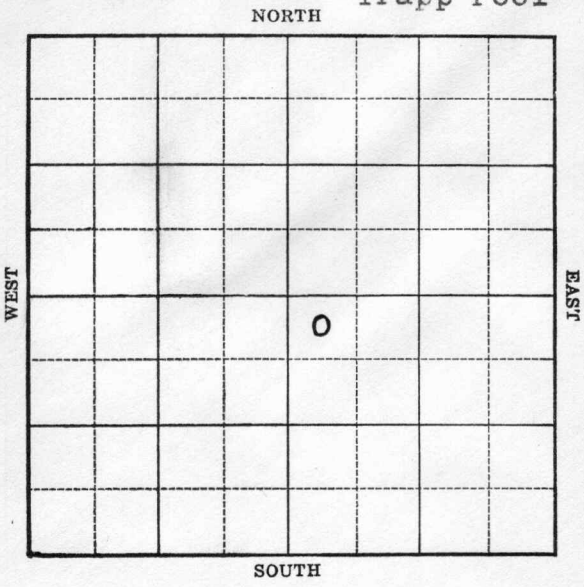

FORM 252-A 5M 10-38 KANSAS Russell

Sec. 23 Twp. 15 R. 14-W

Well No. #2 Bender "D" Farm

Cities-Service Oil Company

(Trapp)


330 Ft. from N. Line

_____ Ft. from S. Line

_____ Ft. from E. Line

330 Ft. from W. Line

Elev. 1906

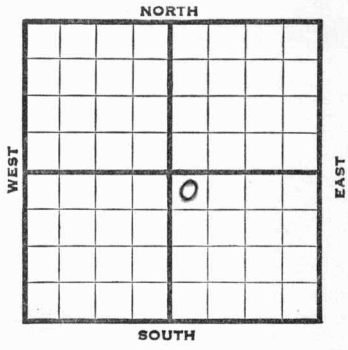

1939	REPORT
2/1	Cellar.
2/10	RUCT.
2/17	Spud.
2/23	15" - 464' Anhy 901'
	Rng. 12".
3/3	12" - 909' Dlg. 1852
3/10	10" - 2285' Drlg. 2425'
3/17	10" - 2532' Drlg. 2865'
3/24	T. D. 3086' U. R. 8".
3/31	8" - 3098' Arb. 3339-40' T.D.
	7" - 3340' WOC.
4/7	T. D. 3354' 2400' oil in 8½
	hours. Bldg. tanks.
4/12	7" - 3340'
	Arb. 3339'
	T.D. 3354'
	2000 acid.
	Pump 324 bbls. 8 hrs.
	Potential 972 bbls.
	COMPLETED

Form 26—1M Bks.—2-29

KANSAS

Russell

Map No. _____ Sec. 23 Twp. 15 R. 14W

Well No. 2 Bender "D"

Cities Service Oil Company

Contractor

FIRST REPORT

NW SE

330 Ft. from N. Line


_____ Ft. from S. Line

_____ Ft. from E. Line

330 Ft. from W. Line

TRAPP POOL

SECTION PLAT

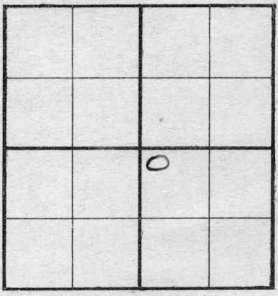

Location _____

Rig up _____

Drilling and Remarks:

Cellar

RECORD

Cased _____ in., _____ ft.

Sand _____

Gas _____

Oil _____

Total Depth _____

PRODUCTION

1st 24 hrs. Nat. _____

1st 24 hrs. after shot _____

Gas _____ Cu. Ft.

Dry Hole _____

Abandoned _____

Date

FEB 1 - 1939 19

H. D. Hatfield Scout

Form 26—1M Bks.—2-29 Russell KANSAS

Map No. 73 Sec. 23 Twp. 15 R. 14W

Well No. 2 Bender "D"

Cities Service Oil Company

Contractor

COMPLETED

NW SE

330 Ft. from N. Line


Ft. from S. Line

Ft. from E. Line

330 Ft. from W. Line

TRAPP POOL

SECTION PLAT

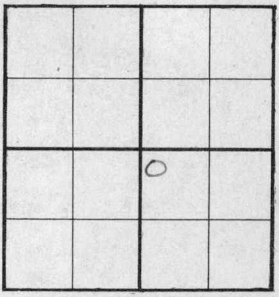

Location

Rig up

Drilling and Remarks:

2000 Acid
P-324/8 hrs
Pot 972

RECORD

Cased 7 in., 3340 ft.

~~Sand~~ Arb 3339

Gas

Oil

Total Depth 3354

PRODUCTION

1st 24 hrs. Nat.

1st 24 hrs. after shot

Gas Cu. Ft.

Dry Hole

Abandoned

Date

APR 12 1939 19

H. D. Hatfield Scout