Cowley KANSAS

SECTION 12 TOWNSHIP 34 RANGE ~~5E~~ 3E

WELL NO. #1 William "A"

COMPANY Jack Busby & Hallmark Drlg.

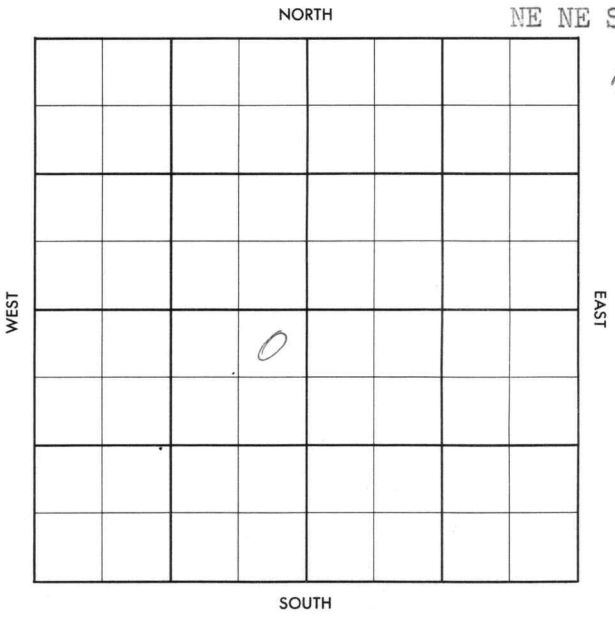

FORM 504-3 SUNRAY

FORM 513 SUNRAY

County Cowley Elev.

Sec. 12 Twp. 34 Rge. 5E

Company Jack Busby & Hallmark Drlg.

Farm Name William "A" No. 1

TOPS	DEPTH	LOG	DATUM
Anh.			
Tp.			
H.			
Tr.			
Dg.			
Bl.			
L.			
K.C.			
B.K.C.			
Ce.			
C.			
M.			
M.			
K.			
Mz.			
Mo.			
V.			
S.			
S.			
A			
R.			
P€.			
G.			
T.D.			

Loc. in Sec. NE NE SW

Geol.

Contr. Hallmark Tools

Pool Rahn

FIRST REPORT

MAY 1957

Date Comm. M I R T

Co. Lse. No. Sec. T. R.

CORRECTION

FORM 513 SUNRAY

County Cowley Elev. 1163

Sec. 12 Twp. 34 Rge. ~~5E~~ 3E

Company Jack Busby & Hallmark Drlg.

Farm Name William "A" No. 1

TOPS	DEPTH	LOG	DATUM
Anh.			
Tp.			
H.			
Tr.			
Dg.			
B.L.			
L.			
K.C. LI	2845		
B.K.C.			
Ce. Bart	3367		
C.			
M.	3381		
M. LI	3401		
K.			
Mz.			
Mo.			
V.			
S.			
S.			
A			
R.			
Pe.			
G.			
T.D.	3416		

Loc. in Sec. NE NE SW

Geol.

Contr. Hallmark Tools

Pool Rahn

ABANDONED

JUN 5 '57

Date Comm.

MIRT MAY 8 '57 5-3-57 8 7/8

85/100 Ø 2103 MAY 15 '57 crd

crd 3370-3403 ream 33' 5.0.

DST 3370-3403 90" 720'

Cas ream 120' OCGCM BHP

710/30" 5½ 3383 WOCT MAY 22 '57

Ø in MAY 29 '57 X co 3416 PB 3401

w/cal seal 1/4 w/Frac 10 x 10 &

Ld (wtr) might plg. JUN 5 '57 D&A

Co. Lse. No. Sec. T. R.