



Map No. \_\_\_\_\_ Sec. 25 Twp. 29 R. 5

Well No. 1 Brown Farm  
Woods Etal Company


**COMPLETED**

200 Ft. from N. Line

\_\_\_\_\_ Ft. from S. Line

\_\_\_\_\_ Ft. from E. Line

200 Ft. from W. Line

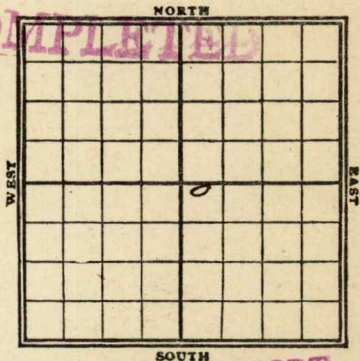

1/20  
Date

REPORT **FIRST REPORT**

<u>7/4</u>	<u>Rig up</u>
<u>11</u>	<u>Loose</u>
<u>24</u>	<u>Spud &amp; SW</u>
<u>3/3</u>	<u>peg 410'</u>
<u>23</u>	<u>" 1530</u>
<u>4/2</u>	<u>" 1675</u>
<u>9</u>	<u>WR 8'14 1945</u>
<u>6/4</u>	<u>Top sand 2718 - Dry in 5 - 2750</u>
<u>6/8</u>	<u>2720-71 35 Hb.</u>

Map No. K11 Sec. 25 Twp. 29 R. 5

Well No. 1 Brown  
Woods et al Company

Contractor

SECTION PLAT

200 Ft. from N. Line  
Ft. from S. Line  
Ft. from E. Line  
200 Ft. from W. Line

		0	

FIRST REPORT

Location

Rig up

Drilling and Remarks:

RECORD

Cased \_\_\_\_\_ in., \_\_\_\_\_ ft.  
Sand \_\_\_\_\_  
Gas \_\_\_\_\_  
Oil \_\_\_\_\_  
Total Depth \_\_\_\_\_

PRODUCTION

1st 24 hrs. Nat. \_\_\_\_\_  
1st 24 hrs. after shot \_\_\_\_\_  
Gas \_\_\_\_\_ Cu. Ft.  
Dry Hole \_\_\_\_\_  
Abandoned \_\_\_\_\_

Date Feb 4 1920

**Pyle** Scout

Map No. K 11 Sec. 25 Twp. 29 R. 5

Well No. 1 Brown  
Hoods et al Company

Contractor

SECTION PLAT

200 Ft. from N. Line

\_\_\_\_\_ Ft. from S. Line

\_\_\_\_\_ Ft. from E. Line

200 Ft. from W. Line

COMPLETED							
						o	

Location \_\_\_\_\_

Rig up \_\_\_\_\_

Drilling and Remarks:

*Shot 30 gts*

RECORD

Cased \_\_\_\_\_ in., \_\_\_\_\_ ft.

Sand 2720-71

Gas \_\_\_\_\_

Oil \_\_\_\_\_

Total Depth \_\_\_\_\_

PRODUCTION

1st 24 hrs. Nat. \_\_\_\_\_

1st 24 hrs. after shot 35 bbls

Gas \_\_\_\_\_ Cu. Ft.

Dry Hole \_\_\_\_\_

Abandoned \_\_\_\_\_

Date \_\_\_\_\_

6/8 19100

**Pyle**

Scout