


Section 13 Township 34 Range 3 E

Well No. # 2 Canfield (Canfield)

Company Aylward Drlg. A

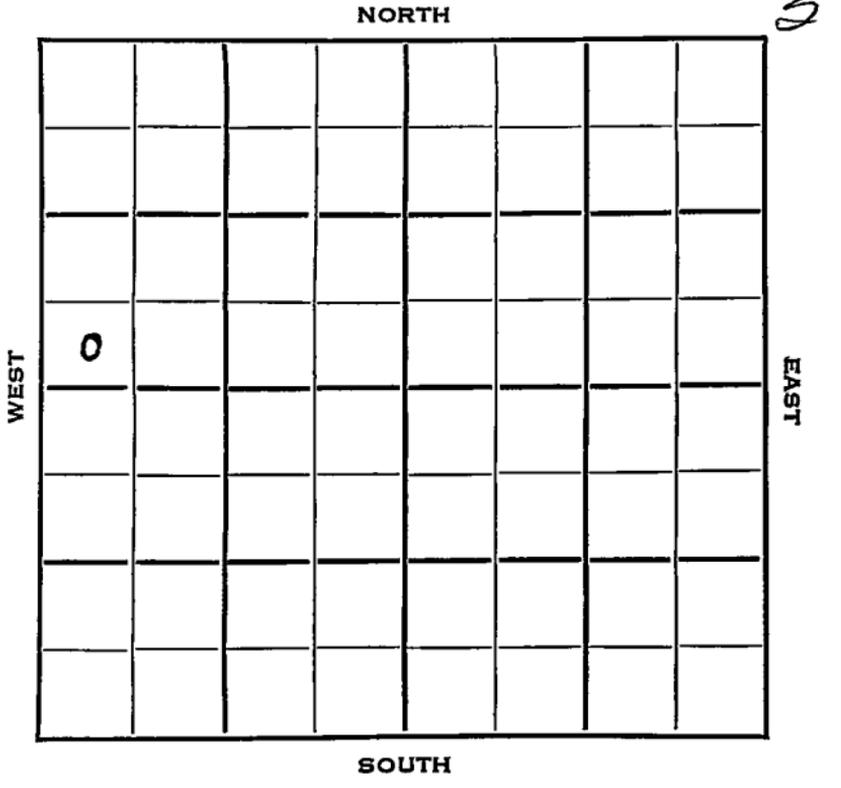

Sec. 13 " Twp. 34 R. 3E

Well No. 2 Canfield Farm

Aylward Drlg. Company

Aylward Drlg. Contractor


_____ Ft. from N. Line

330 Ft. from S. Line

_____ Ft. from E. Line

330 Ft. from W. Line

SW SW NW

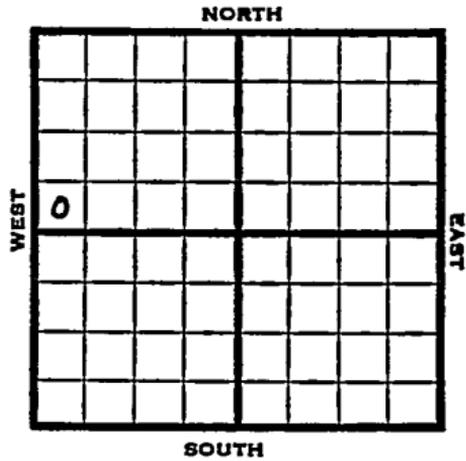

1953 Elev. 1115' REPORT

4/15 Drlg 700'

6/17 Spud 4-11-53 Oil well TD 3377
 8" @ 87 Layton 2632 KC 2835
 Burgess 3348 TD 3352 5" @ 3349
 DD 3377 wtr. PB 2865 19/2825-31
 5 BOPH 25% wtr. Sd-frac.
 P/75 BOPD
 Comp. 41 BOPD 8% wtr.

COMPLETED

