


Section 23 Township 15 Range 14-W

Well No. #3 Bender "B"

Company Cities Service Oil

Trapp Pool

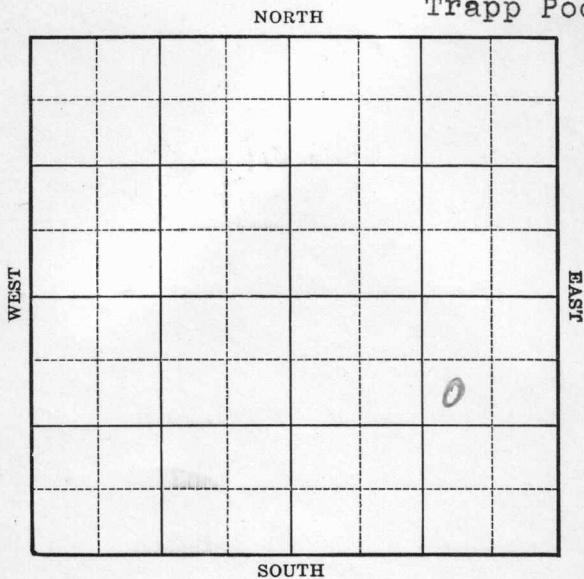

KANSAS

Russell

Sec. 23 Twp. 15 R. 14-WWell No. #3 Bender "B" Farm

Cities Service Oil

Company

(Trapp)

990

Ft. from N. Line


Ft. from S. Line

990

Ft. from E. Line

Ft. from W. Line

Elev. 1893

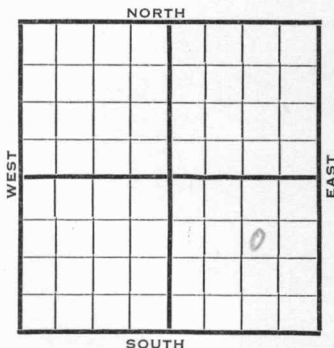

1940

REPORT

8/7 Derrick.

8/14 8" @ 355' Drlg. 970'

8/22 Drlg. 3258'

8/29 Arb. 3342' 5" - 3343'

T.D. 3349' 1050' oil 10 hrs.

2000 acid.

9/4 Arb. 3342'

5" - 3343'

T.D. 3349'

2000 acid.

Echometer potential 848 bbls.

COMPLETED

Map No. 73 Sec. 23 Twp. 15 R. 14WWell No. 3 Bender "B"

Cities Service Oil

Company

Contractor

FIRST REPORT

SW NE SE

990 Ft. from N. Line Ft. from S. Line990 Ft. from E. Line Ft. from W. Line

TRAPP POOL

SECTION PLAT

Location Rig up

Drilling and Remarks:

Derrick

RECORD

Cased in., ft.Sand Gas Oil Total Depth

PRODUCTION

1st 24 hrs. Nat. 1st 24 hrs. after shot Gas Cu. Ft.Dry Hole Abandoned

Date


AUG 7 1940S. J. LEWIS Scout

Map No. 73 Sec. 23 Twp. 15 R. 14WWell No. 3 Bender "B"Cities Service Oil Company

Contractor

COMPLETED**SECTION PLAT**

SW NE SE

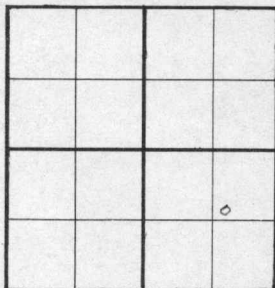990 Ft. from N. Line Ft. from S. Line990 Ft. from E. Line Ft. from W. Line**TRAPP POOL**Location Rig up

Drilling and Remarks:

*Cu 83342**5" C 3343**2000 Ecio**Echometer R 8**848***RECORD**Cased in., ft.Sand Gas Oil Total Depth 3349**PRODUCTION**1st 24 hrs. Nat. 1st 24 hrs. after shot Gas Cu. Ft.Dry Hole Abandoned

Date

SEP 4 1940 19S. J. LEWIS Scout