


Rice

KANSAS

SECTION 11 TOWNSHIP 18 RANGE 7W

WELL NO. #1 Newkirk "B"

COMPANY Bennett & Robert & L.J. Isern

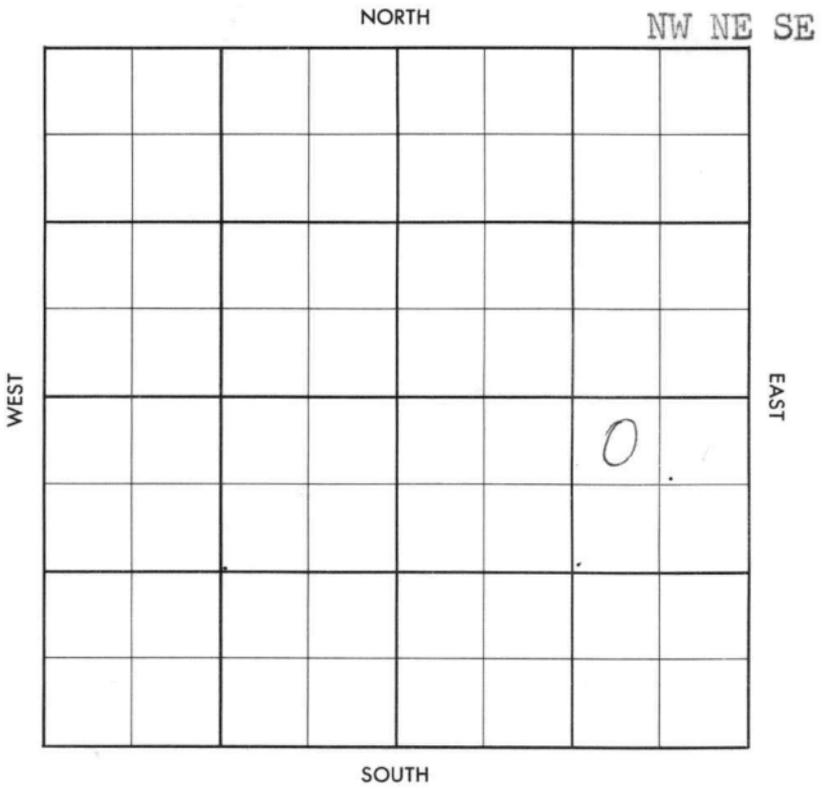

County Rice Elev. _____
 Sec. 11 Twp. 18 Rgs. 7W
 Company Bennett & Robert & L. J. Isern
 FarmName Newkirk "B" No. 1

TOPS	DEPTH	LOG	DATUM
Anh.			
TP.			
H.			
Tr.			
Dg.			
Bl.			
L.			
K.C.			
B.K.C.			
Ce.			
C.			
M.			
M.			
K.			
Mz.			
Mo.			
V.			
S.			
S.			
A.			
R.			
Pe.			
G.			
T.D.			

Loc. in Sec. NW NE SE
 Geol. _____
 Contr. _____
 Pool Crawford
 FIRST REPORT
 MAY 8 '57

Date Comm. Phillips & FO
MIR

[Handwritten signature]

Co.

Lse.

No.

Sec.

T.

R.

County Rice Elev. 1682
 Sec. 11 Twp. 18 Rge. 7W
 Company Bennett & Robert & L. J. Isern
 Farm Name Newkirk "B" No. 1

TOPS	DEPTH	LOG	DATUM
Anb.			
Tr.			
H.	2558		
Tr.	2584		
Dg.	2600		
Bl.	2677		
L.	2711		
K.C.			
B.K.C.	3074		
Ce.			
C.	DP 5d 3144		
M.			
M.			
K.			
Mz.	3194		
Me.			
V.			
S.			
S.			
A.			
R.			
Pe.			
G.			
T.D.	3231		

Loc. in Sec. NW NE SE

Geol. _____

Contr. _____

Pool _____

Crawford

ABANDONED

MAY 22 '57

Date Comm. Phillips # FO

M I R MAY 15 '57 5-7-57 8578 210/15

DST 3046-65 1hr 30' OCM

BHP 105/20" DP 3134 MAY 22 '57 DST

3134-66 1hr see 242' Md + 30'

80' 6" 5W BHP?

D&A