


Cowley

Section 13 Township 34 Range 3E

Well No. 1 Gotlob (Grotlob)

Company Aylward Drlg.

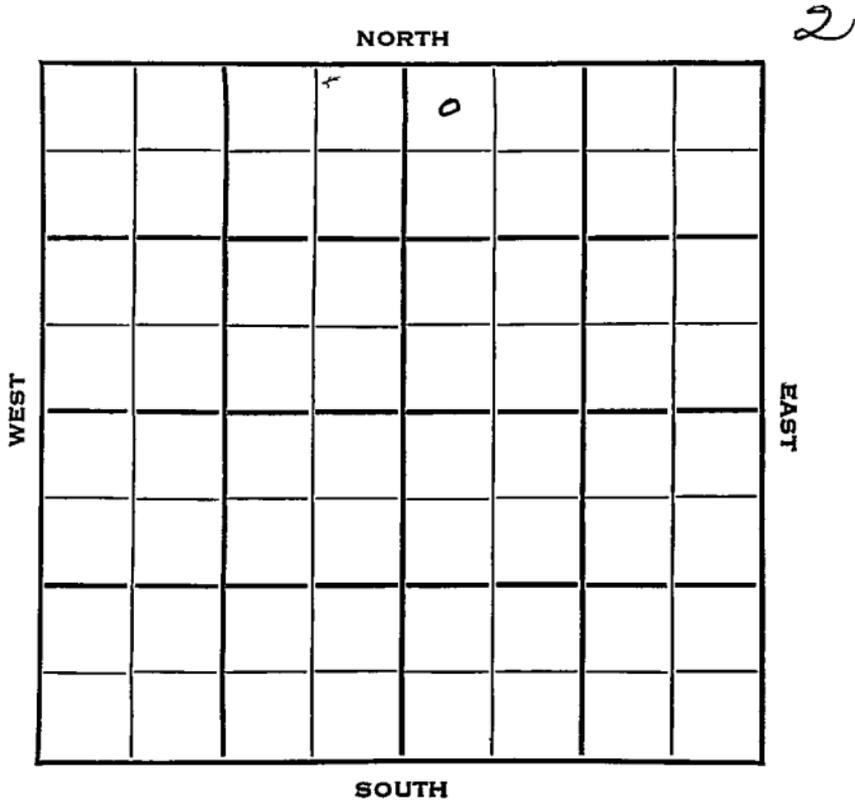

KANSAS ✓

Cowley

Sec. 13 Twp. 34 R. 3E

Well No. 1 Gotlob Farm

Aylward Drlg. Company

Aylward Drlg. Contractor


330 Ft. from N. Line

_____ Ft. from S. Line

_____ Ft. from E. Line

330 Ft. from W. Line

NW NW NE

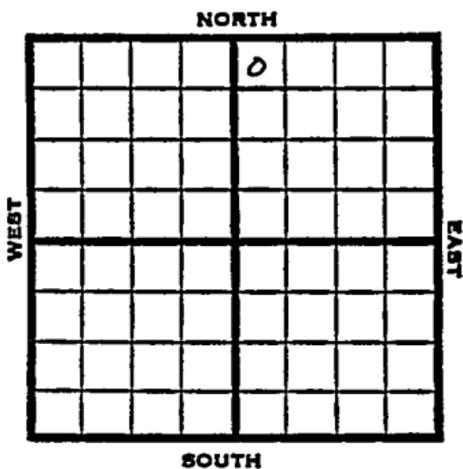

1953

Elev. 1170' REPORT

1/7

MIR

4/1

Spud 1-8-53 Oil well TD 3414'
 8" @ 103 Layton 2655' KC 2853
 Miss. 3398' TD 3414' 5" @ 2836
 Sd 2835-53 60 BO 60 BWPD
 Comp. 25 BOPD 25 BW

COMPLETED

County Cowley State Kansas

Sec. 13 (Blk. Twp.) 34 (Sur. Rge.) 3E Map No.

Operator Aylward Drig.

Well No. 1 Farm Gotlob

Elev. _____ Location NW NW NE

				0		

330 Ft. From N Line NE

330 Ft. From N Line Quarter

Ist. Report JAN 7 1953

Completion _____

Remarks _____

Aylward Drig. - Contr.

Spudding Date _____

Drig. Data _____

M I R

