

Well No. #1 Ocho Farm

NORTH

WEST

0

EAST

SOUTH

Drilling Remarks

Drilling Remarks

PRODUCTION

1st 24 hrs. Nat. _____

1st 24 hrs. after shot_____

Gas_____cu. ft._____

Dry Hole_____

Abandoned _____


Map No. KANSAS Sec. 23 Twp. 15 R. 14^w
Well No. 1- Ochs Farm
Empire & Prairie Oil & Gas Company

990 Ft. from N. Line

_____ Ft. from S. Line

330 Ft. from E. Line

_____ Ft. from W. Line

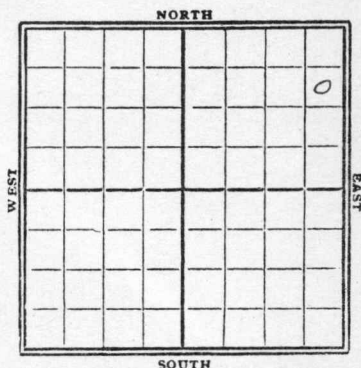

1929

Date	REPORT
7/10	Locations
7/17	Drldg Rig
7/24	Rig
7/31	Rig run up
8/7	Spdg 250'
8/14	Drldg 925'
8-21	" 1400'
8-28	" 2125
9/4	" 2570
9/11	" 2935
9/18	leg collapsed 5" - 3082
9/25	leg 3255'
10/2	UPR 5" - 3340'
	show oil
10/8	2000' oil in hole tubing to pump from sand 3364-66
10/16	TD. 3369 - made 194 bbls on 10/14/29 147 bbls on 15 th 170 bbls on 16 th (over)

10/23- sand 3364-69'

T.D. 3369'

Pump 190 bbl oil
Sump.

73

Map No. KANSAS Sec. 23 Twp. 15 R. 14 W

Well No. 1 Ochr

Empire & Prairie Oil Company

Contractor

SECTION PLAT

			0

990 Ft. from N. Line

_____ Ft. from S. Line

330 Ft. from E. Line

_____ Ft. from W. Line

FIRST REPORTS

Location ✓

Rig up _____

Drilling and Remarks:

RECORD

Cased _____ in., _____ ft.

Sand _____

Gas _____

Oil _____

Total Depth _____

PRODUCTION

1st 24 hrs. Nat. _____

1st 24 hrs. after shot _____

Gas _____ Cu. Ft.

Dry Hole _____

Abandoned _____

Date

JUL 10 1929

19

S. J. LEWIS

Scout

Map No. KANSAS Sec. 23 Twp. 15 R. 14WWell No. 73 1 OaksEmpire & Prairie Oil & Gas Company

Contractor

SECTION PLAT

990 Ft. from N. Line

Ft. from S. Line

380 Ft. from E. Line

Ft. from W. Line

COMPLETED

			0

Location

Rig up

Drilling and Remarks:

Pump 190886

RECORD

Cased in. in., ft. ft.Sand 3364-69

Gas

Oil

Total Depth 3369

PRODUCTION

1st 24 hrs. Nat.

1st 24 hrs. after shot

Gas Cu. Ft.

Dry Hole

Abandoned

Date

OCT 23 1929192S. J. LEWISScout