


Section 14 Township 34 Range 3-E

Well Number 1-Community

Company McNabb

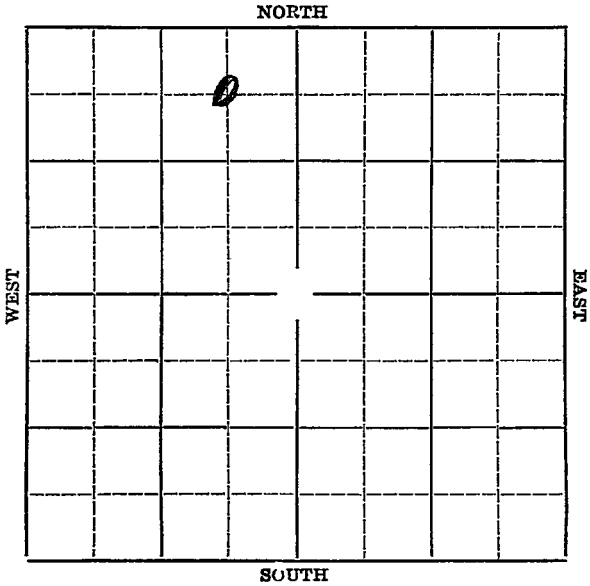

O. W. D. D

KANSAS

Map No. _____ Sec. 14 Twp. 34 R. 3E

Well No. #1 Community Farm _____

McNabb Company _____


660' Ft. from N. Line

_____ Ft. from S. Line

660' Ft. from E. Line

_____ Ft. from W. Line

Elev. 1184

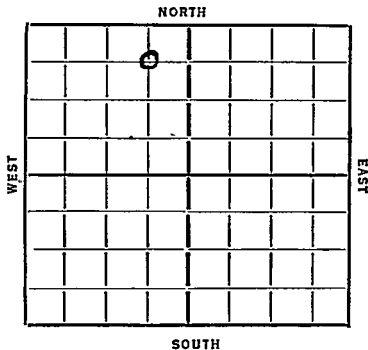

Date	REPORT	O. W. D. D
<u>1936</u>		
<u>4/29</u>	<u>Location</u>	
<u>5/7</u>	<u>--</u>	
<u>5/14</u>	<u>Rigging up.</u>	
<u>5/21</u>	<u>Drlg. 385'.</u>	
<u>5/28</u>	<u>Drlg. 656'.</u>	
<u>6/4</u>	<u>Drlg. 1380'.</u>	
<u>6/11</u>	<u>Drlg. 1850'.</u>	
<u>6/18</u>	<u>2070'. Under reaming 10".</u>	
<u>6/25</u>	<u>2280'. Shut down.</u>	
<u>7/2</u>	<u>Drlg. 2515'.</u>	
<u>7/9</u>	<u>Gas sand 2666-74'. T.D. 5 M. Gas.</u>	
<u>7/15</u>	<u>/36-Gas sand 2666'.</u>	
	<u>T.D. 2674'.</u>	
	<u>7 million gas.</u>	
	<u>1040# rock pressure.</u>	
	COMPLETED	
	OVER	

O. W. D. D

1937

4/7

Sil. 3862'.

T. D. 3880'.

Water.

FIRST REPORT
and
ABANDONED

Map No. 11 Sec. 14 Twp. 34 R. 3E

Well No. 1 Community

Mc Nally Company

Contractor

SECTION PLAT

660 Ft. from N. Line

..... Ft. from S. Line

660 Ft. from E. Line

..... Ft. from W. Line

	o		

FIRST REPORT

Location ✓

Rig up

Drilling and Remarks:

RECORD

Cased..... in., ft.

Sand.....

Gas.....

Oil.....

Total Depth.....

PRODUCTION

1st 24 hrs. Nat.....

1st 24 hrs. after shot.....

Gas..... Cu. Ft.

Dry Hole.....

Abandoned.....

Date

APR 29 1936

192

S. J. LEWIS

Scout

KANSAS

Map No. 1 Sec. 14 Twp. 34 R. 3E

Well No. 1 Community

McNabb Company

Contractor

SECTION PLAT

	0		

660 Ft. from N. Line

_____ Ft. from S. Line

660 Ft. from E. Line

_____ Ft. from W. Line

COMPLETED

Location _____

Rig up _____

Drilling and Remarks:

Gas sand 2666

7M Gas

1040 Rock

RECORD

Cased _____ in., _____ ft.

Sand _____

Gas _____

Oil _____

Total Depth 2674

PRODUCTION

1st 24 hrs. Nat. _____

1st 24 hrs. after shot _____

Gas _____ Cu. Ft.

Dry Hole _____

Abandoned _____

Date

JUL 15 1935

S. J. LEWIS Scout

KANSAS*Rowley*Map No. 1 Sec. 14 Twp. 34 R. 3EWell No. 1 CommunityMcKnauff Company

Contractor

SECTION PLAT

	0		

660 Ft. from N. Line

_____ Ft. from S. Line

660 Ft. from E. Line

_____ Ft. from W. Line

**FIRST REPORT
ABANDONED***OW III*

Location _____

Rig up _____

Drilling and Remarks:

*Sil 3862**Water***RECORD**

Cased _____ in., _____ ft.

Sand _____

Gas _____

Oil _____

Total Depth 3880**PRODUCTION**

1st 24 hrs. Nat. _____

1st 24 hrs. after shot _____

Gas _____ Cu. Ft.

Dry Hole Abandoned

Date

APR 7 1937 19

S. J. LEWIS Scout