


Section 14 Township 34 Range 3E

Well No. #1 Fussell

Company Crest Petroleum

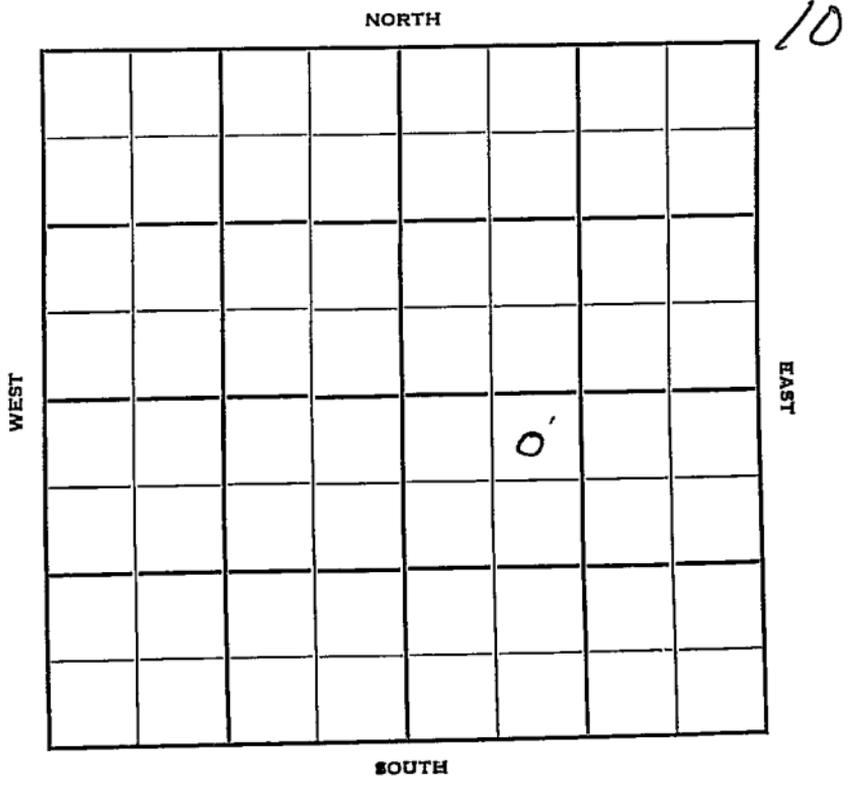

Cowley

O. W. P. B.
KANSAS



Sec. 14 Twp. 34 R. 3E

Well No. #1 Fussell Farm

Crest Petroleum Company


Crest Petr. Contractor

330 Ft. from N. Line

_____ Ft. from S. Line

_____ Ft. from E. Line

990 Ft. from W. Line
NE NW SE

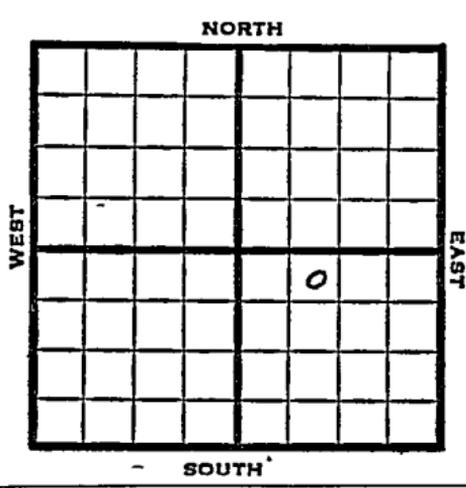

1952

Elev. 1169' REPORT

10/1

RUR

12/3

Spud 9-30-52
 Oil Well
 TD 3376'
 8" @ 68
 Layton 2664, Lans. 2831,
 Bart 3348,
 TD 3360
 5" @ 3349, DD 3376
 PB 3360, Hydro
 P. 40 bopd
 Comp. 20 bopd

COMPLETED

O. W. P. B.

1953

1/28

Oil Well
 TD 3376
 Layton 2664, Lans 2831, Bart
 3348,
 OTD 3376, PB 2857
 18/2839-45, Hydro
 Comp. 30 BOPD

**FIRST REPORT
COMPLETED**

County Cowley State Kansas

Sec. 14 (Blk. Twp.) 34 (Sur. Rge.) 3E Map No.

Operator Crest Petroleum

Well No. 1 Farm Fussell

Elev. Location NE NW SE

330 Ft. From N Line SE

990 Ft. From W Line Quarter

Ist. Report OCT 1 1952

Completion

Remarks

Crest Pet. - Contr.

Spudding Date

Drig. Data Semi Wildcat

R U R

J. G. McGEHEE

