


Cowley

KANSAS

Section 14 Township 34 Range 3E

Well No. #2 Fussell

Company Crest Petroleum Company

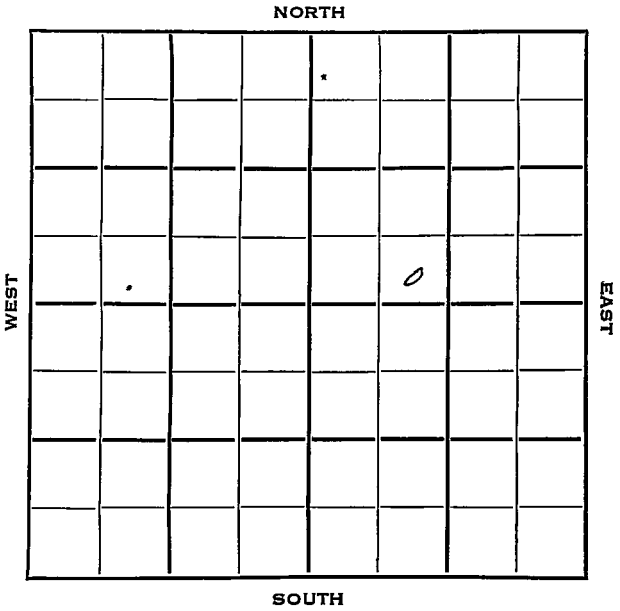

Cowley KANSAS ✓

Sec. 14 Twp. 34 R. 3 E

Well No. # 2 Fussell Farm

Crest Pet. Company

Crest Pet. Contractor


_____ Ft. from N. Line

330 Ft. from S. Line

_____ Ft. from E. Line

990 Ft. from W. Line

SE SW NE

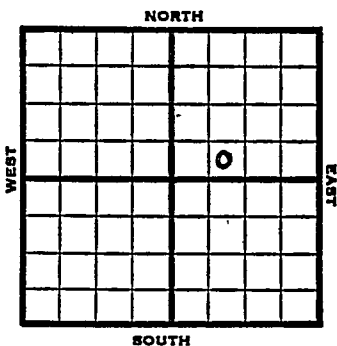

1953 Elev. 1168' REPORT

3/25 Spud 3-24-53

5/13 Spud 3-24-53 Oil well TD 3375
 Stal. 2184 Layton 2662 TD 3370
 5" @ 3362 DD 3375 sd-frac.
 KC 2870 Bart 3355
 Comp. 25 BOPD

COMPLETED

County Cowley State Kansas
 Sec. 14 (Blk.) 34 (Sur.) 3E Map No. (Twp.)
 Operator Crest Pet.
 Well No. 2 Farm Fussell
 Elev. 1168 Location SE SW NE

| | | | | | | | | | |
|-----------------|--|--|--|--|--|--|--|--|--|
| COMPLETE | | | | | | | | | |
| | | | | | | | | | |
| | | | | | | | | | |
330 Ft. From S Line NE
990 Ft. From W Line Quarter

Ist. Report

Completion MAY 13 1953

Remarks

Crest Pet. - Contr.

Spudding Date 3-24-53

Drig. Data Oil well TD 3375

Stal. 2184 Layton 2662 TD 3370

5" @ 3362 DD 3375 sd-frac KC 2870

Bart. 3355 Comp. 25 bopd