


Section 14 Township 34 Range 3E

Well No. #2 Lantz

Company Aylward Drlg.

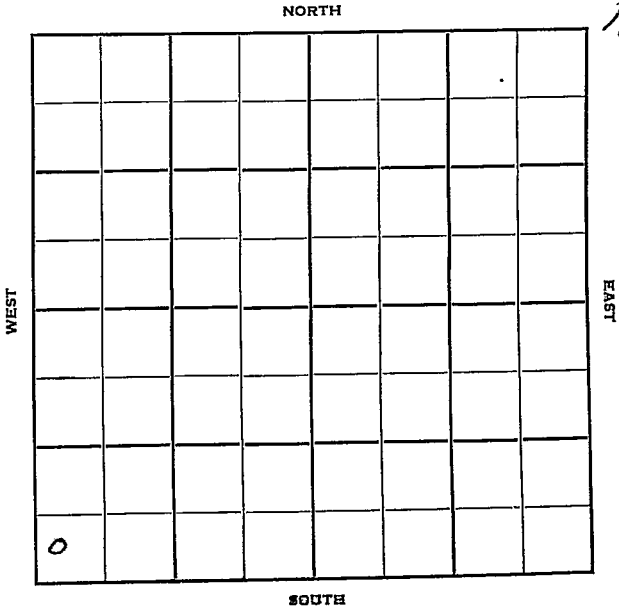

County Cowley State Kansas

Sec. 14 (Blk. 34 (Sur. 3E (Twp.) 3E Map No.

Operator Aylward Drlg.

Well No. 2 Farm Lantz

Elev. 1086 Location SW SW SW

0					

400 Ft. From S Line SW

140 Ft. From W Line Quarter

Ist. Report

Completion JAN 14 1953

Remarks

Spudding Date 11-9-52

Drlg. Data Oil well TD 3287

8" @ 98 Stal. 2127 Layton 2593

KC 2775 Oswego 2960 B KC 3253

Bart. 3272 TD 3287 PB 3283 4 b6ph

D-hydro. F/ 15 boph P/ 100-bopd

Comp. 58 bopd