


Map No. _____ Sec. 25 Twp. 29 R. 5

Well No. 11 Brown Farm
Lewis Oil Company

NORTH

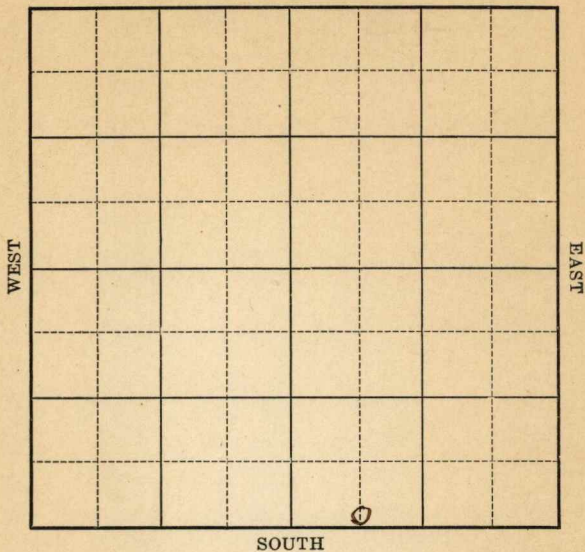

SOUTH

COMPLETED

Location -----

Drilling Remarks:

Rig Up-----

Drilling Remarks:

RECORD

Cased _____ in. _____ ft.

Sand _____

Gas_____

Oil _____

Total Depth -----

PRODUCTION

1st 24 hrs. Nat. -----

1st 24 hrs. after shot-----

Gas -----cu. ft.

Dry Hole-----

Abandoned_ _ _ _ _

Map No. _____ Sec. 25 Twp. 29 R. 5Well No. #11 Brown Farm
Lewis Oil Company

NORTH


_____ Ft. from N. Line

200 Ft. from S. Line

_____ Ft. from E. Line

660 Ft. from W. Line

WEST

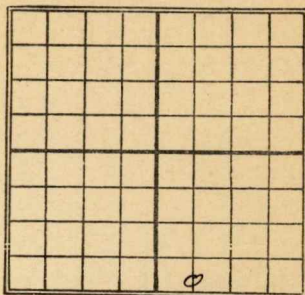

EAST

SOUTH

Date

1922

REPORT

7/15
8/13

Rig
Ed 2707-27
Shot 20 qts 50 blers

Map No. Kas 11 Sec. 25 Twp. 29 R. 5Well No. 11 BrownLewis oil Company

Contractor

FIRST REPORT

SECTION PLAT

Ft. from N. Line

200

Ft. from S. Line

Ft. from E. Line

660

Ft. from W. Line

Location

Rig up

Drilling and Remarks:

Rig.

RECORD

Cased _____ in., _____ ft.

Sand _____

Gas _____

Oil _____

Total Depth _____

PRODUCTION

1st 24 hrs. Nat. _____

1st 24 hrs. after shot _____

Gas _____ Cu. Ft.

Dry Hole _____

Abandoned _____

Date

JUL 15 1922191M. A. BENEAR

Scout

Map No. 11 Sec. 25 Twp. 29 R. 5Well No. 11 BrownLewis oil Company

Contractor

COMPLETED

SECTION PLAT

		0	

Ft. from N. Line

200 Ft. from S. Line

Ft. from E. Line

660 Ft. from W. Line

Location

Rig up

Drilling and Remarks:

shot 20 ft

RECORD

Cased in., ft.

Sand 2707-27

Gas

Oil

Total Depth 2727

PRODUCTION

1st 24 hrs. Nat.

1st 24 hrs. after shot 30

Gas Cu. F

Dry Hole

Abandoned

Date

AUG 13 1922 191

M. A. BENEAR

Scou