

KANSAS


FORM 51 IOM 12-46 PETROL

Butler county

Section 25 Township 29 Range 5-E

Well No. #1, Haver

Company United Oil and Gas etal

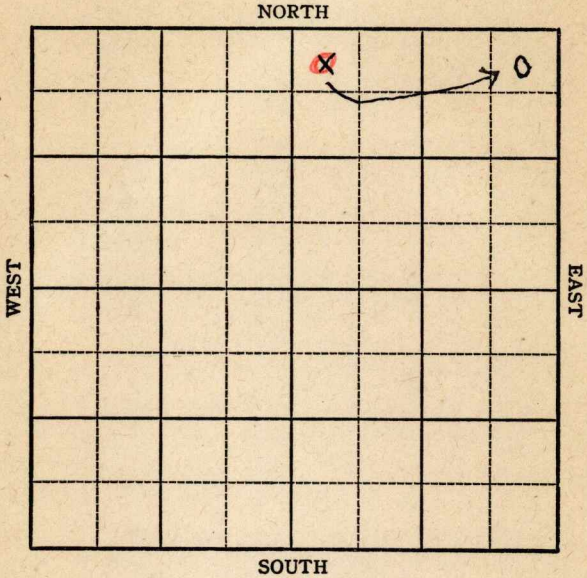

Sec. 25 Twp. 29 R. 5-E

Well No. #1, Haver Farm
United Oil and Gas Company et al Company

Miscellaneous

430' Ft. from N. Line


 Ft. from S. Line

330 Ft. from E. Line

~~330'~~ Ft. from W. Line

NE/c

~~NW NE~~

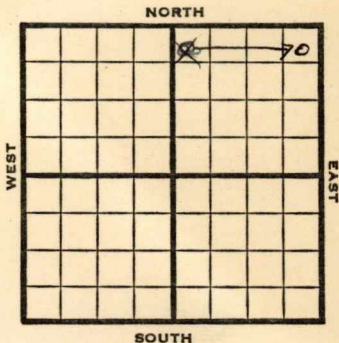

1946 **Elev. 1336** REPORT

12/11 12" @ 750'
10" @ 1640'
Drlg. 1660'
12/17 8" @ 1942
Drlg 2230'

1947

1/4 TD 2800
6" @ 2682'
Bart 2682'

1/8 " "

1/15 **Bart 2682'**
6" @ 2682'
TD 2814'
Pump 15 Pot
39-GR

COMPLETED

Map No. _____ Sec. 25 Twp. 29 R. 5EWell No. 1 Haver

United Oil and Gas etal. _____ Company

FIRST REPORT

Contractor _____

NW NE

SECTION PLAT

		0	

430 Ft. from N. Line

_____ Ft. from S. Line

_____ Ft. from E. Line

330 Ft. from W. LineButler County

Location _____

Rig up _____

Drilling and Remarks:

12" @ 750

10" @ 1640

drlg. 1660

RECORD

Cased _____ in., _____ ft.

Sand _____

Gas _____

Oil _____

Total Depth _____

PRODUCTION

1st 24 hrs. Nat. _____

1st 24 hrs. after shot _____

Gas _____ Cu. Ft.

Dry Hole _____

Abandoned _____

Date

DEC 1 1 1946 19S. J. LEWIS

Scout

Map No. 1 Sec. 25 Twp. 29 R. 5E

Well No. 1 Haver

United Oil & Gas etal. Company

CORRECTION

Contractor

NE/C

SECTION PLAT

430 Ft. from N. Line

 Ft. from S. Line

330 Ft. from E. Line

 Ft. from W. Line

			0

Butler County

Location

Rig up

Drilling and Remarks:

Reported NW NE

RECORD

Cased in., ft.

Sand

Gas

Oil

Total Depth

PRODUCTION

1st 24 hrs. Nat.

1st 24 hrs. after shot

Gas Cu. Ft.

Dry Hole

Abandoned

Date

JAN 8 1947 19


S. J. LEWIS Scout

Map No. 11 Sec. 25 Twp. 29 R. 5EWell No. 1 HaverUnited Oil & Gas etal. Company

COMPLETE

Contractor

NE/C

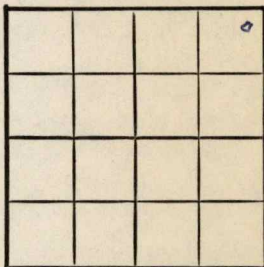E1, 1886
SECTION PLAT430 Ft. from N. Line Ft. from S. Line330 Ft. from E. Line Ft. from W. LineButler CountyLocation Rig up

Drilling and Remarks:

Bar 26826" 2682Pump 158289° 30'

RECORD

Cased in., ft.Sand Gas Oil Total Depth 2874

PRODUCTION

1st 24 hrs. Nat. 1st 24 hrs. after shot Gas Cu. Ft.Dry Hole Abandoned

Date

JAN 15 1947

19

S. J. LEWIS

Scout