


Cowley

KANSAS

Section 14 Township 34 Range 3E

Well No. 1 Mercer

Company Empire Drlg.

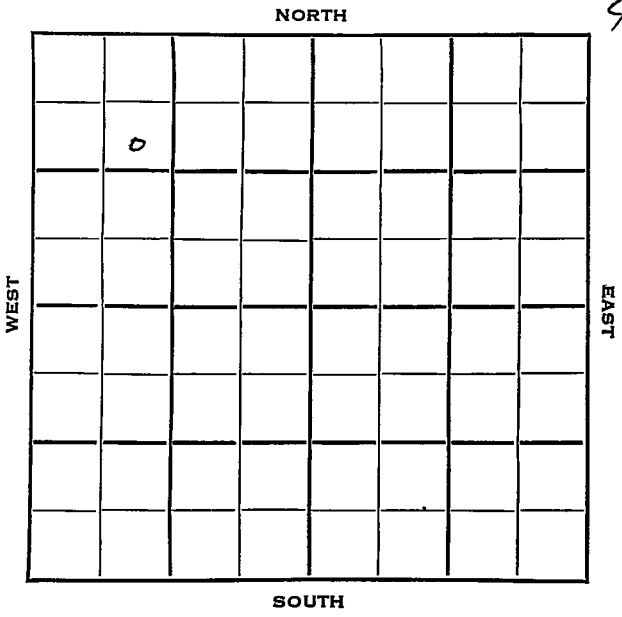

Sec. 14 Twp. 34 R. 3E

Well No. #1 Mercer Farm

Empire Drl g. Company

Empire Drlg. Contractor


990 Ft. from N. Line

\_\_\_\_\_ Ft. from S. Line

\_\_\_\_\_ Ft. from E. Line

990 Ft. from W. Line

SE NW NW

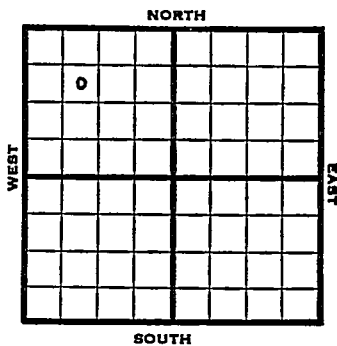

1953 Elev. 1181' REPORT

1/28 Spud 1-20-53  
8" @ 105  
Drlg. 2100

4/8 Spud 1-20-53  
D&A  
TD 3408  
8" @ 105  
Layton 2666  
DST 2666-75, opn 1 hr., rec. 30' so &  
gem, 120' sw, 875#  
Bart 3366½  
TD 3373  
5" @ 3367  
CO to 3 373, Hydro, S/3 boph, DD 3408  
D&A

**ABANDONED**



County Cowley State Kansas

Sec. 14 (Blk. Twp.) 34 (Sur. Rge.) 3E Map No.

Operator Empire Drlg.

Well No. 1 Farm Mercer

Elev. 1181 Location SE NW NW

0							

990 Ft. From N Line NW

990 Ft. From W Line Quarter

1st. Report

Completion APR 8 1953

Remarks

Empire Drlg. - Contr.

Spudding Date 1-20-53

Drlg. Data D & A TD 3408

8" @ 105 Layton 2666 DST 2666-75

open 1 hr. Rec. 30' so & gcm 120' sw

875# Bart. 3366 $\frac{1}{2}$  TD 3373 5" @ 3367

CO to 3373 Hydro. S/ 3 boph DD 3408

D & A