

WEST

EAST

SOUTH

COMPLETED

Drilling Remarks:

Drilling Remarks:

Cased _____ in. _____ ft.
 Sand _____
 Gas _____
 Oil _____
 Total Depth _____

1st 24 hrs. Nat. -----
1st 24 hrs. after shot -----
Gas ----- cu. ft.
Dry Hole -----
Abandoned -----

Map No. 12 Sec. 25 Twp. 29 R. 3

Well No. 4 Brown Farm


Lewis Oil Company

Ft. from N. Line

810 Ft. from S. Line

Ft. from E. Line

200 Ft. from W. Line

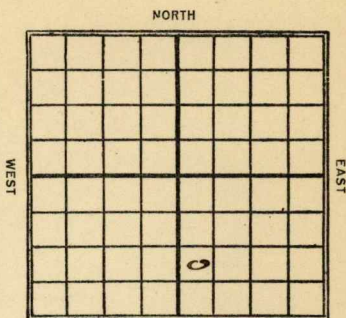

SOUTH COMPLETED

Date


REPORT

1/22

1/3 Qty 2310
1/5 2505-2772 -
Shot 50 yds pump
20 ft

Map No. 11 Sec. 23 Twp. 29 R. 5Well No. 4 Brown FarmLewis Oil CompanyDate Started _____ Ft. from N _____ S 120 E _____ W 200 lineNORTH Kansas

WEST

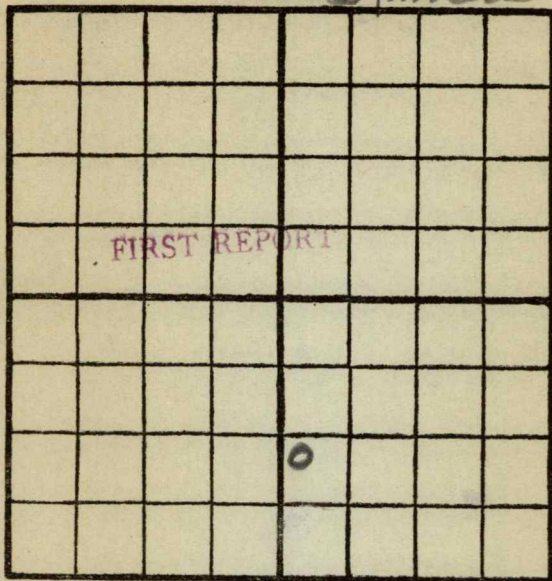

EAST

SOUTH

Cased _____ In. _____ Ft.

Production Remarks

Sand _____

Pay { Gas _____
Oil _____

Total Depth _____

Condition of Well on this date _____

Log. at 2310'

A. BENEAR

Scout

Map No. K11 Sec. 25 Twp. 29 R. 3
 Well No. 4 Brown
Lewis Oil Company
 Contractor

Completed

SECTION PLAT

-----Ft. from N. Line
1120' Ft. from S. Line
 -----Ft. from E. Line
200' Ft. from W. Line

Location -----
 Rig up -----
 Drilling and Remarks:
sand { 2705
{ 2772
shot 20 gals
pump ing 20
116

RECORD

Cased ----- in., ----- ft.
 Sand -----
 Gas -----
 Oil -----
 Total Depth -----

PRODUCTION

1st 24 hrs. Nat. -----
 1st 24 hrs. after shot -----
 Gas ----- Cu. Ft.
 Dry Hole -----
 Abandoned -----

Date 1/22 1915 M.B. Scout